



NORTH

MANCHESTER, MO 63021

	In the second se			Coversheet Code & general notes	& GENERAL		SITE PLAN	SITE DETAILS	ANS	FLOOR PLAN-AREA A	FLOOR PLAN-AREA B	ROOF PLAN & ROOF DETAILS	EI EVATIONS & BUJII DING SECTIONS	ELEVATIONS	EXTERIOR ELEVATIONS	PARTIAL EXTERIOR ELEVATIONS	BUILDING SECTIONS	BUILDING SECTIONS	) PLANS & INTERIOR ELEVATIONS	enlarged plans	interior elevations & casework	CEILING PLAN			WALL SECTIONS & DETAILS	Wall Details	WALL DETAILS		column details	WALL DETAILS	WINDOW DETAILS
	bzwick@zgarch-stl.com 314-962-9292	ARCHITECTURAL		CVR A0.01	AQ.02	SITEWORK	A1.00	A1.01	FLOOR PLANS	A2.00	A2.01	A2.10	EXTERIOR	A3.00	A3.01	A3.02	A3.10	A5.11	ENLARGED	A4.00	A5.00	REFLECTED	A6.00	A6.01	WALL SECT	A8.01	A8.02	A8.03	A8.04	A8.05	A8.06
$\wedge$	BID /PERMIT / CONST. ADDENDUM 1		/2019 /2019	••			•	•		•	•	•		•	•	•	•			•	•		•	•		•	•	•	•	•	•
/ 1 \																															

	GENERAL DOCUMENT NOTES	MATERIA	15
	THE CONTRACT DOCUMENTS CONTEMPLATE A FINISHED PIECE OF WORK OF SUCH CHARACTER AND QUALITY AS IS DESCRIBED IN AND IS REASONABLY INFERABLE FROM THEM AND THE CONTRACTOR AND SUB-CONTRACTORS RECOGNIZING THE IMPOSSIBILITY OF PRODUCING DRAWINGS AND SPECIFICATIONS WITH PERFECT ACCURACY, AGREES THAT HIS SUBMITTED BID OR COST FOR THE WORK HEREUNDER INCLUDES SUFFICIENT MONEY ALLOWANCE TO MAKE HIS WORK COMPLETE AND OPERABLE, AND IN COMPLIANCE WITH GOOD PRACTICE AND THE ORDINANCES, CODES AND REGULATIONS OF ALL BODIES OR PERSONS HAVING GOVERNMENTAL AUTHORITY OVER IT.		EARTH
	DRAWINGS, SPECIFICATIONS AND OTHER DOCUMENTS, INCLUDING THOSE IN ELECTRONIC FORM, PREPARED BY THE ARCHITECT AND THE ARCHITECT'S CONSULTANTS ARE INSTRUMENTS OF SERVICE FOR USE SOLELY WITH RESPECT TO THIS PROJECT ONLY. THE ARCHITECT AND THE ARCHITECT'S CONSULTANTS SHALL BE DEEMED THE AUTHORS AND OWNERS OF THEIR RESPECTIVE INSTRUMENTS OF SERVICE AND SHALL RETAIN ALL COMMON LAW, STATUTORY AND OTHER RESERVED RIGHTS, INCLUDING COPYRIGHTS.		ROCK/POROVS FILL
	THE OWNER AND ARCHITECT RELY COMPLETELY ON THE GENERAL CONTRACTOR AND ITS SUBCONTRACTORS TO MAINTAIN A SAFE ENVIRONMENT FOR THE CONSTRUCTION OF THE WORK. IN ADDITION, THE GENERAL CONTRACTOR IS SOLELY RESPONSIBLE FOR THE SEQUENCING, MEANS AND METHODS TO CONSTRUCT THE WORK WITH THE HIGHEST QUALITY BY THE INTENT OF THE DOCUMENTS. TO THE FULLEST EXTENT PERMITTED BY LAW, THE OWNER SHALL INDEMNIFY AND HOLD HARMLESS THE CONTRACTOR, SUBCONTRACTORS, ARCHITECT, ARCHITECT'S CONSULTANTS AND AGENTS AND		CONCRETE
	EMPLOYEES OF ANY OF THEM FROM AND AGAINST CLAIMS, DAMAGES, LOSSES AND EXPENSES, INCLUDING BUT NOT LIMITED TO ATTORNEY'S FEES, ARISING OUT OF OR RESULTING FROM PERFORMANCE OF THE WORK IN THE AFFECTED AREA IF IN FACT THE MATERIAL OR SUBSTANCE PRESENTS THE RISK OF BODILY INJURY OR DEATH AND HAS NOT BEEN RENDERED HARMLESS, PROVIDED THAT SUCH CLAIM, DAMAGE, LOSS OR EXPENSE IS ATTRIBUTABLE TO BODILY INJURY, SICKNESS, DISEASE OR DEATH, OR TO INJURY OR TO DESTRUCTION OF TANGIBLE PROPERTY (OTHER THAN THE WORK ITSELF) AND PROVIDED THAT SUCH DAMAGE, LOSS OR EXPENSE IS NOT DUE TO THE SOLE NEGLIGENCE OF A PARTY SEEKING INDEMNITY. THE OWNER SHALL NOT BE RESPONSIBLE		BRICK
	FOR MATERIALS AND SUBSTANCES BROUGHT TO THE SITE BY THE CONTRACTOR UNLESS SUCH MATERIALS OF SUBSTANCES WERE REQUIRED BY THE CONTRACT DOCUMENTS. IF, WITHOUT NEGLIGENCE ON THE PART OF THE CONTRACTOR, THE CONTRACTOR IS HELD LIABLE FOR THE COST OF REMEDIATION OF A HAZARDOUS MATERIAL OR SUBSTANCE SOLELY BY REASON OF PERFORMING WORK AS REQUIRED BY THE CONTRACT DOCUMENTS, THE OWNER SHALL INDEMNIFY THE CONTRACTOR FOR ALL COST AND EXPENSE THEREBY INCURRED.		СМИ
	THE CONTRACT DOCUMENTS CONSIST OF THE AGREEMENT BETWEEN OWNER AND CONTRACTOR (HEREINAFTER THE AGREEMENT), CONDITIONS OF THE CONTRACT (GENERAL, SUPPLEMENTARY, AND OTHER CONDITIONS), DRAWINGS, SPECIFICATIONS, ADDENDA ISSUED PRIOR TO THE EXECUTION OF THE CONTRACT, OTHER DOCUMENTS LISTED IN THE AGREEMENT AND MODIFICATIONS ISSUED AFTER EXECUTION OF THE CONTRACT. A MODIFICATION IS (1) A WRITTEN AMENDMENT TO THE CONTRACT SIGNED BY BOTH PARTIES, (2) A CHANGE ORDER, (3) A		CVT STONE/PRECAST
	CONSTRUCTION CHANGE DIRECTIVE OR (4) A WRITTEN ORDER FOR A MINOR CHANGE IN THE WORK ISSUED BY THE ARCHITECT. UNLESS SPECIFICALLY ENUMERATED IN THE AGREEMENT, THE CONTRACT DOCUMENTS DO NOT INCLUDE OTHER DOCUMENTS SUCH AS BIDDING REQUIREMENTS (ADVERTISEMENT OR INVITATION TO BED, INSTRUCTIONS TO BIDDERS, SAMPLE FORMS, THE CONTRACTOR'S BID OR PORTIONS OF ADDENDA RELATING TO BIDDING REQUIREMENTS. THE CONTRACT DOCUMENTS FORM THE CONTRACT FOR CONSTRUCTION. THE CONTRACT		FINISH LUMBER
	REPRESENTS THE ENTIRE AND INTEGRATED AGREEMENT BETWEEN THE PARTIES HERETO AND SUPERSEDES PRIOR NEGOTIATIONS, REPRESENTATIONS OR AGREEMENTS, EITHER WRITTEN OR ORAL. THE CONTRACT MAY BE AMENDED OR MODIFIED ONLY BY A MODIFICATION. THE CONTRACT DOCUMENTS SHALL NOT BE CONSTRUED TO CREATE A CONTRACTUAL RELATIONSHIP OF ANY KIND (1) BETWEEN THE ARCHITECT AND CONTRACTOR, (2) BETWEEN THE OWNER AND A SUBCONTRACTOR OR SUB-SUBCONTRACTOR, (3) BETWEEN THE OWNER AND THE ARCHITECT OR (4) BETWEEN ANY PERSONS OR ENTITIES OTHER THAN THE OWNER AND CONTRACTOR. THE		discont. lumber
	ARCHITECT SHALL, HOWEVER, BE ENTITLED TO PERFORMANCE AND ENFORCEMENT OF OBLIGATIONS UNDER THIS CONTRACT INTENDED TO FACILITATE PERFORMANCE OF THE ARCHITECT'S DUTIES. THE DRAWINGS ARE THE GRAPHIC AND PICTORIAL PORTIONS OF THE CONTRACT DOCUMENTS		Continuous lumber
	SHOWING THE DESIGN, LOCATION AND DIMENSIONS OF THE WORK, GENERALLY INCLUDING PLANS, ELEVATIONS, SECTIONS, DETAILS, SCHEDULES AND DIAGRAMS. THE SPECIFICATIONS ARE THAT PORTION OF THE CONTRACT DOCUMENTS CONSISTING OF THE WRITTEN REQUIREMENTS FOR MATERIALS, EQUIPMENT, SYSTEMS, STANDARDS AND WORKMANSHIP FOR THE WORK, AND PERFORMANCE OF RELATED SERVICES.		STEEL
)	THE PROJECT MANUAL IS A VOLUME ASSEMBLED FOR THE WORK WHICH MAY INCLUDE THE BIDDING REQUIREMENTS, SAMPLE FORMS, CONDITIONS OF THE CONTRACT AND SPECIFICATIONS. THE INTENT OF THE CONTRACT DOCUMENTS IS TO INCLUDE ALL ITEMS NECESSARY FOR THE PROPER EXECUTION AND COMPLETION OF THE WORK BY THE CONTRACTOR. THE CONTRACT DOCUMENTS ARE COMPLEMENTARY, AND WHAT IS REQUIRED BY ONE SHALL BE AS BINDING AS IF REQUIRED BY ALL; PERFORMANCE OF THE WORK BY THE CONTRACTOR SHALL BE REQUIRED ONLY TO THE EXTENT CONSISTENT WITH THE CONTRACT DOCUMENTS AND REASONABLY INFERABLE FROM		BLANKET INSULATION
	THEM AS BEING NECESSARY TO PRODUCE THE INDICATED RESULTS. ORGANIZATION OF THE SPECIFICATIONS INTO DIVISIONS, SECTIONS AND ARTICLES, AND ARRANGEMENT OF DRAWINGS SHALL NOT CONTROL THE CONTRACTOR IN DIVIDING THE WORK AMONG SUBCONTRACTORS OR IN ESTABLISHING THE EXTENT OF WORK TO BE PERFORMED BY ANY TRADE. UNLESS OTHERWISE STATED IN THE CONTRACT DOCUMENTS, WORDS WHICH HAVE WELL-KNOWN TECHNICAL OR CONSTRUCTION INDUSTRY MEANINGS ARE USED IN THE CONTRACT DOCUMENTS IN ACCORDANCE WITH SUCH RECOGNIZED MEANINGS. EXECUTION OF THE CONTRACT BY THE CONTRACTOR IS A REPRESENTATION THAT THE		RIGID INSULATION
2	CONTRACTOR HAS BECOME GENERALLY FAMILIAR WITH LOCAL CONDITIONS UNDER WHICH THE WORK IS TO BE PERFORMED AND CORRELATED PERSONAL OBSERVATIONS WITH REQUIREMENTS OF THE ALL MATERIALS ON THIS PROJECT MUST BE INSTALLED BY LICENSED, EXPERIENCED AND/ OR APPROVED INSTALLERS OF THAT PRODUCT/ MATERIAL AND A MINIMUM 3 YEARS EXPERIENCE IN GOOD STANDING BY THE MANUFACTURER OF THAT PRODUCT/ MATERIAL (NO EXCEPTIONS). ALL		sheathing
	INSTALLERS MUST BE FULLY AWARE OF THE MANUFACTURERS' INTENDED DESIGN LIMITATIONS/ PURPOSE AND USE OF THE MATERIAL BEING INSTALLED AND THE LATEST PUBLISHED INSTALLATION INSTRUCTIONS, SUBSTRATE REQUIREMENTS OR USE OF THE THIS MATERIAL IN CONJUNCTION WITH OTHER ADJACENT MATERIALS AND SUBSTRATES. NO PRODUCT IS TO BE ORDERED OR INSTALLED THAT DOES NOT MEET OR EXCEED THE LATEST PUBLISHED CONDITIONS FOR HANDLING & INSTALLATION BY THE MANUFACTURER. ANY DISCREPANCIES BETWEEN THE DOCUMENTS AND THE EXISTING CONDITIONS, SUBSTRATES, OR FINAL INSTALLATION ARE TO BE BROUGHT TO THE		MARBLE/GRANITE
5	ATTENTION OF THE ARCHITECT PRIOR TO COMMENCING WORK. THE INTENT OF THE SPECIFICATIONS, DRAWINGS AND DETAILS, WHETHER SHOWN OR NOT ARE TO DETAIL/ SPECIFY, DELIVER, INSTALL AND COMPLETE CONSTRUCTION WITH ALL PRODUCTS/ MATERIALS PER MANUFACTURERS' SPECIFIC REQUIREMENTS ALLOWING THE PRODUCTS/ MATERIALS TO MEET THE MANUFACTURERS' INTENT FOR LONG-TERM PERFORMANCE. THIS INCLUDES PRODUCTS/MATERIALS BY THEM SELVES OR AS AN ASSEMBLY IN CONJUNCTION WITH OTHER MATERIALS COMPATIBLE WITH THE MANUFACTURER.		

THE GENERAL CONTRACTOR, ALL SUPPLIERS, SUBCONTRACTORS AND SUB-SU ENCOVRAGED TO BRING DISCREPANCIES, CONFLICTS OR CONCERNS TO THE ARCHITECT IN AN EFFORT TO WORK IN COLLABORATION. THE GOAL IS TO V COLLECTIVELY TO AVOID CONFLICTS AND ADDITIONAL COST, BUT MOST IMPC THE INSTALLATION OF ALL MATERIALS/ PRODUCTS TO BE INSTALLED PROPER MANUFACTURERS' EXPRESSED INTENT TO ENSURE LONG-TERM PERFORMANC

NTS, EITHER WRITTEN OR ORAL. CATION. THE CONTRACT		DISC	CON	T. I	LUM	BER						SECTIO	on is	DRAV	VN -			
AL RELATIONSHIP OF ANY KIND OWNER AND A IER AND THE ARCHITECT OR AND CONTRACTOR. THE ENFORCEMENT OF								D	eta	<u>\ L</u> k	<u>(EY</u>	1				TION FICAT		
FORMANCE OF THE E CONTRACT DOCUMENTS		COI	NTIN	IVC	DUS I	LUMBE	2				l	A2.0	_	E		WHEI TION WN		
GENERALLY INCLUDING MENTS CONSISTING OF THE	<u></u>							<u>E</u>	<u>XTE</u>	<u>RIO</u>	<u>r ei</u>	EV/		E	ELEVA	tion Ifica <sup>-</sup>		
ICH MAY INCLUDE THE		STE	EL								(	3 - A3.0		—— S E	HEET	whei tion	RE	
FRACT AND SPECIFICATIONS. AS NECESSARY FOR THE PROPER THE CONTRACT DOCUMENTS S BINDING AS IF REQUIRED BY EQUIRED ONLY TO THE NABLY INFERABLE FROM ORGANIZATION OF THE		BLA	NKE	11 TE	NSU	LATION	1		shadi	ED ARE ATES E	ĒA		1 4.0	)				
ANGEMENT OF DRAWINGS MONG SVBCONTRACTORS OR RADE. VNLESS OTHERWISE -KNOWN TECHNICAL OR DOCVMENTS IN ACCORDANCE		RIG	id in	NSU	lat	ION			OF ELI	l num evatic D N	<sub>DN</sub> / <u>OTE</u>			E		WHEI TION WN		
TATION THAT THE NDITIONS UNDER WHICH THE IONS WITH REQUIREMENTS OF									$\langle \mathbf{x} \rangle$ $\langle \mathbf{x} \rangle$ $\langle \mathbf{x} \rangle$ $\mathbf{x}$	EL	MOLIT EVATIO ANS							
EXPERIENCED AND/ OR NUM 3 YEARS EXPERIENCE IN ERIAL (NO EXCEPTIONS). ALL NDED DESIGN LIMITATIONS/		SHE	ATH	IINC	Ē					$\leq$	RECTIC	ON OF :						
TEST PUBLISHED INSTALLATION ERIAL IN CONJUNCTION WITH BE ORDERED OR INSTALLED NS FOR HANDLING & EEN THE DOCUMENTS AND RE TO BE BROUGHT TO THE		MA	RBLE	E/GI	ran	IITE			/A6.( 00'-(	4	h	ND SH				ER		
THER SHOWN OR NOT ARE TO WITH ALL PRODUCTS/ NG THE PRODUCTS/ M PERFORMANCE. THIS LY IN CONJUNCTION WITH																		
D SUB-SUBCONTRACTORS ARE TO THE ATTENTION OF THE L IS TO WORK TOGETHER, DST IMPORTANTLY TO ALLOW PROPERLY PER THE DRMANCE.																		
DAMAINEL.																		
		STANDARD DETAILS	GRADE PLAN		DETAILS	ILS												
RON		TANDA	NO	Z	CTIONS & D	& DETAILS												
ROMACKER		general notes & 5 <sup>-</sup>	FOUNDATION & SLAB	F FRAMING PLAN	ATION SE	FRAMING SECTIONS												
RON ROMACKER	R	GENI	FOU	ROOI	FOUND,	FRAI												
rsquareromacker@gmail.com 636-667-7937	STRUCTURAL	S1.0	52.0	S2.1	53.0	53.1												
BID / PERMIT / CONST.	05/23/2019		•	•	•	•												-
																		1

<u>symbols</u>

<u>RATED PARTITIONS</u>

1 HR RATED WALL

\_\_\_\_\_ 2 HR RATED WALL

DOOR IDENTIFICATION

100

WINDOW TYPE

<u>revision</u>

, DOOR NUMBER

 WINDOW
 STOREFRONT

 IDENTIFICATION
 IDENTIFICATION

 ALWAYS
 SYSTEM

 NUMERICAL
 IDENTIFICATION

<u>ROOM/SPACE IDENTIFICATION</u>

OFFICE - ROOM NAME

<u>PARTITION TYPES KEY</u>

<u>section keys</u>

BUILDING SECTION

106 - ROOM NUMBER

CLOVD AROUND REVISION

 #
 U = UNDER

 T = THROUGH
 S = STRUCTURAL

 P = PARTIAL

A5.4 SHEET WHERE SECTION IS DRAWN

PARTITION TYPE


WALL SECTION


1 10:00	
SCHEDULES	
• A9.00	door schedule
<ul> <li>A9.03</li> </ul>	FINISH SCHEDULE
• A9.10	partition types



		$\overline{\mathbf{A}}$		$\overline{\gamma}$				$\bigcirc$				
1							Window -DING BAY@ PORCH: Vinyl/Fiberglass Frame:Operable, Perf. Specs.: Product ID SIL-N-3, SHGC 0.30, PF 0.67, [Bldg. Use 1 - Multifamily] (b)	15			0.290	0.400
	COM <i>check</i> Software				<b>C</b> <sup>-</sup>		Window - lvg bay wndw @porch: Vinyl/Fiberglass Frame:Operable, Perf. Specs.: Product ID SIL-N-3, SHGC 0.30, PF 0.84, [Bldg. Use 1 - Multifamily] (b)	52			0.290	0.400
	<b>Envelope Cor</b>	npliar	nce	Certi	ficat	te	Door 1: Glass (> 50% glazing):Nonmetal Frame, Entrance Door, Perf. Specs.: Product ID n/a, SHGC 0.12, PF 0.52, [Bldg. Use 1 - Multifamily] (b) Orientation: SOUTH	56	0.00	575	0.230	0.400
							Exterior Wall 4: Wood-Framed, 16" o.c., [Bldg. Use 1 - Multifamily]	961	19.0	3.6	0.052	0.064
	Section 1: Project Information						Window -bdrm: Vinyl/Fiberglass Frame, Perf. Specs.: Product ID sil-n-3, SHGC 0.30, PF 0.02, [Bldg. Use 1 - Multifamily] (b)	80			0.290	0.400
	Energy Code: <b>2009 IECC</b> Project Title: New Memory care residence						Window Living bay: Vinyl/Fiberglass Frame, Perf. Specs.: Product ID sil-n-3, SHGC 0.30, PF 0.69, [Bldg. Use 1 - Multifamily] (b)	17			0.290	0.400
	Project Type: New Construction		Deet				Window Dng bay: Vinyl/Fiberglass Frame, Perf. Specs.: Product ID sil-n-3, SHGC 0.30, PF 0.19, [Bldg. Use 1 - Multifamily] (b)	19	222		0.290	0.400
	Construction Site:Owner/Agent:351-377 Forest Summit CourtBarth HolohanManchester, MO 63021Family Partners, II		Bria	gner/Contra n Zwick ck + Gandt A		Inc	Window Crtyd toilet: Vinyl/Fiberglass Frame, Perf. Specs.: Product ID sil-n-3, SHGC 0.30, PF 0.02, [Bldg. Use 1 - Multifamily] (b) Window Sunrm side: Vinyl/Fiberglass Frame, Perf. Specs.: Product	14			0.290	0.400
	Manchester, MO 63021 Failing Partners, in 12880 Manchester St. Louis, MO 631	rd.	9109	9 Watson rd. _ouis, MO 63	; ste 110	IIIC.	ID sil-n-3, SHGC 0.30, PF 0.61, [Bldg. Use 1 - Multifamily] (b) Door Res wil exit: Insulated Metal, Swinging, [Bldg. Use 1 -	8 20			0.290 0.100	0.400
	(314) 686-4450		314-	-962-9292 ick@zgarch-			Multifamily] Door 5: Glass (> 50% glazing):Nonmetal Frame, Non-Entrance	20			0.230	0.400
	Building Location (for weather data):Manchester, MissonClimate Zone:4a	ri		o o de la construction de la			Door, Perf. Specs.: Product ID n/a, SHGC 0.12, PF 0.39, [Bldg. Use 1 - Multifamily] (b)	20			0.200	0.400
	Vertical Glazing / Wall Area Pct.: 17%						Orientation: WEST					
	Building Use: Activity Type(s)F1-Multifamily : Residential	<u>oor Area</u> 7148					Exterior Wall 2: Wood-Framed, 16" o.c., [Bldg. Use 1 - Multifamily] windows resident corridor: Vinyl/Fiberglass Frame, Perf. Specs.:	1268 50	19.0 	3.6 	0.052 0.290	0.064 0.400
	Section 2: Envelope Assemblies and Requ		Checkli	st			Product ID SIL-N-3, SHGC 0.30, PF 0.02, [Bldg. Use 1 - Multifamily] (b) Window lounge/activity: Vinyl/Fiberglass Frame, Perf. Specs.:	115			0.290	0.400
	Envelope PASSES: Design 1% better than code.						Product ID SIL-N-3, SHGC 0.30, PF 0.26, [Bldg. Use 1 - Multifamily] (b)	110			0.200	0.400
	Envelope Assemblies:						Window sunrm center: Vinyl/Fiberglass Frame, Perf. Specs.: Product ID SIL-N-3, SHGC 0.30, PF 0.65, [Bldg. Use 1 - Multifamily] (b)	63			0.290	0.400
	Component Name/Description	Gross Area or Perimeter	Cavity R-Value		Proposed U-Factor	Budget U-Factor(a)	Window sunrm side: Vinyl/Fiberglass Frame, Perf. Specs.: Product ID SIL-N-3, SHGC 0.30, PF 0.50, [Bldg. Use 1 - Multifamily] (b) Orientation: UNSPECIFIED ORIENTATION	15	5556	575	0.290	0.400
$\bigwedge$	Orientation: NORTH	T CHINCLE						7110	20.0	0.0	0.034	0.027
(	Exterior Wall 3: Wood-Framed, 16" o.c., [Bldg. Use 1 - Multifamily	961	19.0	3,6	0.052	0.064	Roof 1: Attic Roof with Wood Joists, [Bldg. Use 1 - Multifamily] Floor 1: Slab-On-Grade:Unheated, Vertical 2 ft., [Bldg. Use 1 -	7148	30.0	0.0		
	Window BEDRM: Vinyl/Fiberglass Frame, Perf. Specs.: Product SIL-N-3, SHGC 0.30, PF 0.02, [Bldg. Use 1 - Multifamily] (b)				0.290	0.400	Multifamily]	468		5.0		
	Window LIVING- BAY: Vinyl/Fiberglass Frame, Perf. Specs.: Product ID SIL-N-3, SHGC 0.30, PF 0.69, [Bldg. Use 1 -	17	-222		0.290	0.400	<ul><li>(a) Budget U-factors are used for software baseline calculations ONLY, and a</li><li>(b) Fenestration product performance must be certified in accordance with N</li></ul>				umentation.	
	Multifamily] (b) Window -DING BAY: Vinyl/Fiberglass Frame, Perf. Specs.: Produ ID SIL-N-3, SHGC 0.30, PF 0.19, [Bldg. Use 1 - Multifamily] (I		10.00		0.290	0.400	Air Leakage, Component Certification, and Vapor Reta	rder Re	quiremer	nts:		
	Window CRTYD TOILET: Vinyl/Fiberglass Frame, Perf. Specs.: Product ID SIL-N-3, SHGC 0.30, PF 0.02, [Bldg. Use 1 -	14	1202	222	0.290	0.400	<ol> <li>All joints and penetrations are caulked, gasketed or covered with a mo with the manufacturer's installation instructions.</li> </ol>		or-permeab	le wrapping	g material ins	stalled in accordance
	Multifamily] (b) Window SUNRM SIDE: Vinyl/Fiberglass Frame, Perf. Specs.:	8	1200	1992	0.290	0.400	<ul> <li>2. Windows, doors, and skylights certified as meeting leakage requireme</li> <li>3. Component R-values &amp; U-factors labeled as certified.</li> </ul>					
							4. No roof insulation is installed on a suspended ceiling with removable of a suspended ceiling with removable of the support	ceiling pan	iels.			
7	Product ID SIL-N-3, SHGC 0.30, PF 0.61, [Bldg. Use 1 - Multifamily] (b)						5. 'Other' components have supporting documentation for proposed U-F					
	Multifamily] (b) Door res wing exit: Insulated Metal, Swinging, [Bldg. Use 1 - Multifamily]	20			0.100	0.700	<ul> <li>6. Insulation installed according to manufacturer's instructions, in substa achieves the rated R-value without compressing the insulation.</li> </ul>	actors. ntial conta				
	Multifamily] (b) Door res wing exit: Insulated Metal, Swinging, [Bldg. Use 1 - Multifamily] Door Snrm door: Glass (> 50% glazing):Nonmetal Frame, Non-Entrance Door, Perf. Specs.: Product ID n/a, SHGC 0.12 PF 0.39, [Bldg. Use 1 - Multifamily] (b)	20			0.100 0.230	0.700 0.400	<ul> <li>G. Insulation installed according to manufacturer's instructions, in substate achieves the rated R-value without compressing the insulation.</li> <li>T. Stair, elevator shaft vents, and other outdoor air intake and exhaust of dampers.</li> <li>8. Cargo doors and loading dock doors are weather sealed.</li> </ul>	actors. ntial conta penings in	the building	envelope a	are equipped	with motorized
	Multifamily] (b) Door res wing exit: Insulated Metal, Swinging, [Bldg. Use 1 - Multifamily] Door Snrm door: Glass (> 50% glazing):Nonmetal Frame, Non-Entrance Door, Perf. Specs.: Product ID n/a, SHGC 0.12 PF 0.39, [Bldg. Use 1 - Multifamily] (b) Orientation: EAST	20			0.230	0.400	<ul> <li>6. Insulation installed according to manufacturer's instructions, in substate achieves the rated R-value without compressing the insulation.</li> <li>7. Stair, elevator shaft vents, and other outdoor air intake and exhaust of dampers.</li> <li>8. Cargo doors and loading dock doors are weather sealed.</li> <li>9. Recessed lighting fixtures installed in the building envelope are Type</li> </ul>	actors. ntial conta penings in IC rated as	the building	envelope a	are equipped	with motorized
	Multifamily] (b) Door res wing exit: Insulated Metal, Swinging, [Bldg. Use 1 - Multifamily] Door Snrm door: Glass (> 50% glazing):Nonmetal Frame, Non-Entrance Door, Perf. Specs.: Product ID n/a, SHGC 0.12 PF 0.39, [Bldg. Use 1 - Multifamily] (b)	20 ] 1268 45	 19.0				<ul> <li>6. Insulation installed according to manufacturer's instructions, in substationachieves the rated R-value without compressing the insulation.</li> <li>7. Stair, elevator shaft vents, and other outdoor air intake and exhaust of dampers.</li> <li>8. Cargo doors and loading dock doors are weather sealed.</li> <li>9. Recessed lighting fixtures installed in the building envelope are Type</li> <li>10. Building entrance doors have a vestibule equipped with self-closing de <i>Exceptions:</i></li> </ul>	actors. ntial conta penings in IC rated as	the building	envelope a	are equipped	with motorized
	Multifamily] (b) Door res wing exit: Insulated Metal, Swinging, [Bldg. Use 1 - Multifamily] Door Snrm door: Glass (> 50% glazing):Nonmetal Frame, Non-Entrance Door, Perf. Specs.: Product ID n/a, SHGC 0.12 PF 0.39, [Bldg. Use 1 - Multifamily] (b) Orientation: EAST Exterior Wall 1: Wood-Framed, 16" o.c., [Bldg. Use 1 - Multifamily Window -BAY WDWS: Vinyl/Fiberglass Frame:Operable, Perf. Specs.: Product ID sil-n-3, SHGC 0.30, PF 0.18, [Bldg. Use 1 Multifamily] (b)	20 ] 1268 45	 19.0	3.6	0.230 0.052 0.290	0.400 0.064 0.400	<ul> <li>6. Insulation installed according to manufacturer's instructions, in substate achieves the rated R-value without compressing the insulation.</li> <li>7. Stair, elevator shaft vents, and other outdoor air intake and exhaust of dampers.</li> <li>8. Cargo doors and loading dock doors are weather sealed.</li> <li>9. Recessed lighting fixtures installed in the building envelope are Type</li> <li>10. Building entrance doors have a vestibule equipped with self-closing doces.</li> </ul>	actors. ntial conta penings in IC rated as	the building	envelope a	are equipped	with motorized
	Multifamily] (b) Door res wing exit: Insulated Metal, Swinging, [Bldg. Use 1 - Multifamily] Door Snrm door: Glass (> 50% glazing):Nonmetal Frame, Non-Entrance Door, Perf. Specs.: Product ID n/a, SHGC 0.12 PF 0.39, [Bldg. Use 1 - Multifamily] (b) Orientation: EAST Exterior Wall 1: Wood-Framed, 16" o.c., [Bldg. Use 1 - Multifamily Window -BAY WDWS: Vinyl/Fiberglass Frame:Operable, Perf. Specs.: Product ID sil-n-3, SHGC 0.30, PF 0.18, [Bldg. Use 1	20 - - 50	 19.0 	3.6	0.230 0.052	0.400 0.064	<ul> <li>6. Insulation installed according to manufacturer's instructions, in substationachieves the rated R-value without compressing the insulation.</li> <li>7. Stair, elevator shaft vents, and other outdoor air intake and exhaust of dampers.</li> <li>8. Cargo doors and loading dock doors are weather sealed.</li> <li>9. Recessed lighting fixtures installed in the building envelope are Type</li> <li>10. Building entrance doors have a vestibule equipped with self-closing de <i>Exceptions:</i></li> </ul>	actors. ntial conta penings in IC rated as evices.	the building	envelope a	are equipped	with motorized

Project Title: New Memory care residence Report date: 06/10/19 Data filename: N:\Active Project Files\Family Partners\18036.00 Family Partners\Correspondence\Code Approach\Comcheck\Family Data filename: N:\Active Project Files\Family Partners\18036.00 Family Partners\correspondence\c

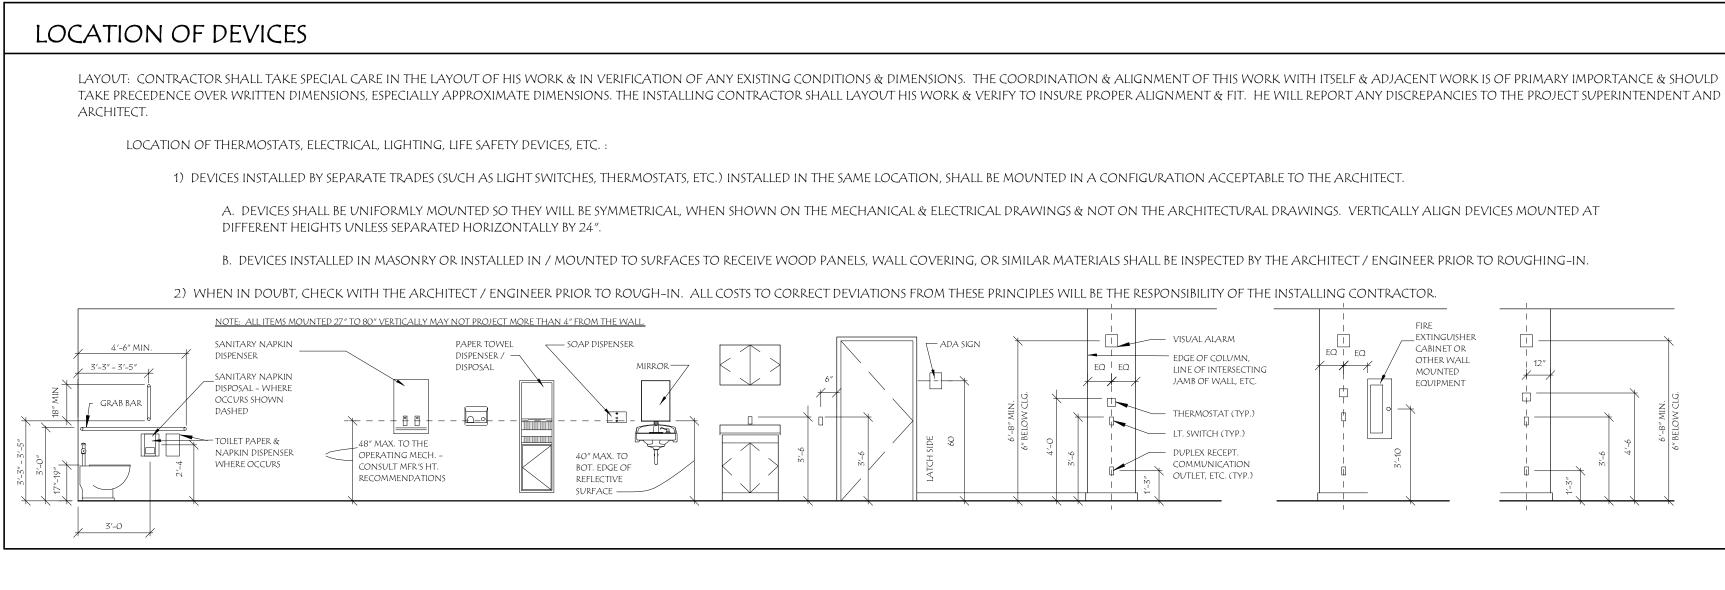


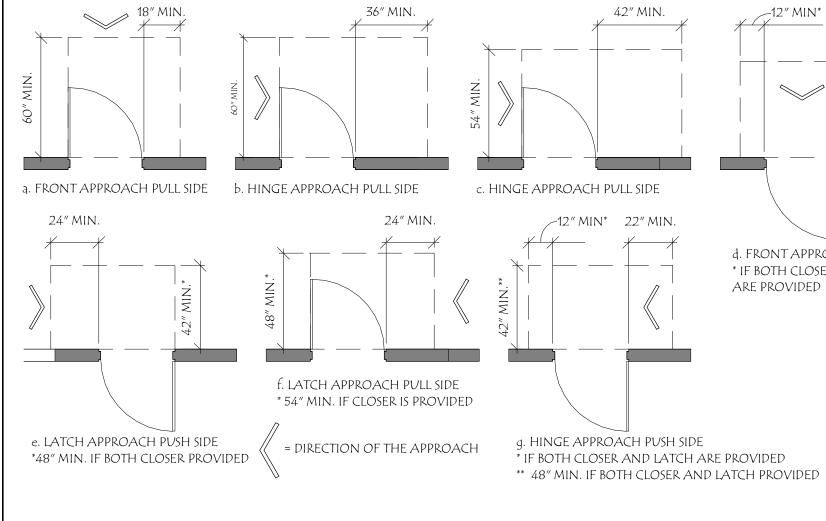

Window -DING BAY@ PORCH: Vinyl/Fiberglass Frame:Operable, Perf. Specs.: Product ID SIL-N-3, SHGC 0.30, PF 0.67, [Bldg. Use 1 - Multifamily] (b)	15			0.290	0.400
Window - Ivg bay wndw @porch: Vinyl/Fiberglass Frame:Operable, Perf. Specs.: Product ID SIL-N-3, SHGC 0.30, PF 0.84, [Bldg. Use 1 - Multifamily] (b)	52			0.290	0.400
Door 1: Glass (> 50% glazing):Nonmetal Frame, Entrance Door, Perf. Specs.: Product ID n/a, SHGC 0.12, PF 0.52, [Bldg. Use 1 - Multifamily] (b)	56	0.00	675	0.230	0.400
Orientation: SOUTH					
Exterior Wall 4: Wood-Framed, 16" o.c., [Bldg. Use 1 - Multifamily]	961	19.0	3.6	0.052	0.064
Window -bdrm: Vinyl/Fiberglass Frame, Perf. Specs.: Product ID sil-n-3, SHGC 0.30, PF 0.02, [Bldg. Use 1 - Multifamily] (b)	80	1000	1000	0.290	0.400
Window Living bay: Vinyl/Fiberglass Frame, Perf. Specs.: Product ID sil-n-3, SHGC 0.30, PF 0.69, [Bldg. Use 1 - Multifamily] (b)	17			0.290	0.400
Window Dng bay: Vinyl/Fiberglass Frame, Perf. Specs.: Product ID sil-n-3, SHGC 0.30, PF 0.19, [Bldg. Use 1 - Multifamily] (b)	19		2222	0.290	0.400
Window Crtyd toilet: Vinyl/Fiberglass Frame, Perf. Specs.: Product ID sil-n-3, SHGC 0.30, PF 0.02, [Bldg. Use 1 - Multifamily] (b)	14	11111		0.290	0.400
Window Sunrm side: Vinyl/Fiberglass Frame, Perf. Specs.: Product ID sil-n-3, SHGC 0.30, PF 0.61, [Bldg. Use 1 - Multifamily] (b)	8			0.290	0.400
Door Res wil exit: Insulated Metal, Swinging, [Bldg. Use 1 - Multifamily]	20	222		0.100	0.700
Door 5: Glass (> 50% glazing):Nonmetal Frame, Non-Entrance Door, Perf. Specs.: Product ID n/a, SHGC 0.12, PF 0.39, [Bldg. Use 1 - Multifamily] (b)	20		575	0.230	0.400
Orientation: WEST					
Exterior Wall 2: Wood-Framed, 16" o.c., [Bldg. Use 1 - Multifamily]	1268	19.0	3.6	0.052	0.064
windows resident corridor: Vinyl/Fiberglass Frame, Perf. Specs.: Product ID SIL-N-3, SHGC 0.30, PF 0.02, [Bldg. Use 1 - Multifamily] (b)	50	222		0.290	0.400
Window lounge/activity: Vinyl/Fiberglass Frame, Perf. Specs.: Product ID SIL-N-3, SHGC 0.30, PF 0.26, [Bldg. Use 1 - Multifamily] (b)	115			0.290	0.400
Window sunrm center: Vinyl/Fiberglass Frame, Perf. Specs.: Product ID SIL-N-3, SHGC 0.30, PF 0.65, [Bldg. Use 1 - Multifamily] (b)	63			0.290	0.400
Window sunrm side: Vinyl/Fiberglass Frame, Perf. Specs.: Product ID SIL-N-3, SHGC 0.30, PF 0.50, [Bldg. Use 1 - Multifamily] (b)	15	222	575	0.290	0.400
Orientation: UNSPECIFIED ORIENTATION					
Roof 1: Attic Roof with Wood Joists, [Bldg. Use 1 - Multifamily]	7148	30.0	0.0	0.034	0.027
Floor 1: Slab-On-Grade:Unheated, Vertical 2 ft., [Bldg. Use 1 - Multifamily]	468		5.0		

Data filename: N:\Active Project Files\Family Partners\18036.00 Family Partners\Correspondence\Code Approach\Comcheck\Family

Project Title: New Memory care residence

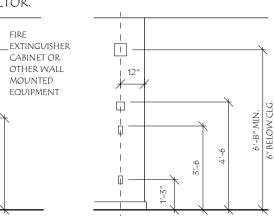

Report date: 06/10/19

Page 2 of 3

12" MIN*	]				
	48″ MIN.	TYPE OF	- USE	MINIMUM M	ANEUVERING CLEARANCES
		APPROACH DIRECTION	DOOR SIDE	PERPENDICULAR F TO DOORWAY	ARALLEL TO DOORWAY (BEYOND LATCH UNLESS NOTED)
$\backslash$		FROM FRONT	PULL	60 INCHES	18 INCHES
		FROM FRONT	PUSH	48 INCHES	O INCHES ***
		FROM HINGE SIDE	PULL	60 INCHES	36 INCHES
	CH PUSH SIDE	FROM HINGE SIDE	PULL	54 INCHES	42 INCHES
	AND LATCH	FROM HINGE SIDE	PUSH	42 INCHES *	22 INCHES ***&****
ROVIDED		FROM LATCH SIDE	PULL	48 INCHES **	24 INCHES
CONDED					
KUVIDED		FROM LATCH SIDE	push	42 INCHES **	24 INCHES

\*\*\* ADD 12 INCHES BEYOND LATCH IF CLOSER AND LATCH PROVIDED BEYOND HINGE SIDE

GOVERNING CC	)DES:	$\sum$	$\rangle \sim$	$\sim$
PROPOSED BVILE FOLLOW TO BE I BVILDING CODE	N COMPLI	ANCE WIT	TH THE CIT	YOF
BVILDING CODE: ENERGY CODE: ELECTRICAL COD PLVMBING CODE MECHANICAL CO	20 DE: 20 E: 20	009 IBC/IM 008 NATIC 009 UNIFC	DNAL ELEC DRM MECH	TRICA IANICA
FVEL GAS CODE: FIRE CODE:			CH. 1108.21 R WEST CO	UNTY
<u>CHAPTER 3 - US</u>	E AND OC	CUPANCY	<u>/</u> :	$\checkmark$
<b>non-separ</b> Primary USE Accessory C	e is for <b>"r</b>	-4″, CONI		
<b>SECTION 310.6 -</b> " GROUP R- CONSTRUCTI FOR IN THIS (	-4 OCCUPA ON AS DEF	NCIES SH.	ALL MEET	
<u>CHAPTER 4 – DE</u>	TAILED RE	OVIREME	ents on u	<u>'SE AN</u>
SECTION 420.2 - " WALLS SEI SEPARATING CONSTRUCTE	PARATING SLEEPIN	sleeping g units f	i Units in Rom othe	ER OCC
<b>SECTION 420.4</b> GROVP R OC				
<u>CHAPTER 5 – GE</u>	NERAL BU	'ILDING H	<u>EIGHTS AN</u>	<u>ND ARI</u>
section 503.1 -	GENERAL			
		YPE <b>VB</b> & 0 = <b>7,000 Sf</b>	GROUP <b>R-4</b>	ţ
<u>Chapter 6 – Ty</u> Table 601 – Fire				ement
HOURLY FIRE RA FIRE SEPARATIO STRUCTURAL BEARING WA EXTERIOR INTERIOR NONBEARIN EXTERIOR INTERIOR ROOF CONST	n distanc FRAME Alls 2 G WALLS 2 2	E OF <b>15 F</b> 0 0 0 0 0 0 0		TION 6
<u>CHAPTER 7 – FIR</u>	<u>Re And SM</u>	OKE PRO	<u>TECTION F</u>	EATU
EXCEP	ss than <b>1</b> Ptions	HR		
1) COI 1020.1	rridor W. 1	ALLS ARE	PERMITTEL	) 10 H.
UNDERSII Assembly <u>OR,</u> Fo	<b>3.4 - CONT</b> TITIONS SH DE OF ROC Y ABOVE, A OR COMBU SHEATHING	IALL EXTE PF SHEATH AND SHAL /STIBLE CC	HING OR FI L BE SECUR INSTRUCTI	RE-RE ELY A <sup>T</sup> ONT
	stopping Led Roof	shall be	INSTALLED	) TO SL
	<b>3.4.3 – OTH</b> Topping sh Uch that	HALL BE IN	ISTALLED I	
<u>CHAPTER 8 – IN</u>	<u>TERIOR FII</u>	<u>NISHES:</u>		
CLASS B:	<b>5.1.1 – WAL</b> Flame Sf Flame Sf Flame Sf	PREAD 0-2 PREAD 26-	25; SMOKE 75; SMOKE	DEVEL DEVEL

CLASS C: FLAME SPREAD 76-200; SMOKE DEVELOPED 0-450 TABLE 803.9: FINISH REQUIREMENTS BY OCCUPANCY GROUP R-4 & "NOT SPRINKLERED" (NFPA 13D DOES NOT QUALIFY): VERTICAL EXITS AND EXIT PASSAGEWAYS: MINIMUM CLASS A EXIT ACCESS CORRIDORS AND OTHER EXIT WAYS: MINIMUM CLASS **B** 

Rooms and enclosed spaces: MINIMVM class **B** 

### CHAPTER 9 - FIRE PROTECTION SYSTEMS:

SECTION 903.2.8.1 - GROUP R-3 OR R-4 CONGREGATE RESIDENCES AN AVTOMATIC SPRINKLER SYSTEM IN ACCORDANCE WITH 901.3.1.3 SHALL BE PERMITTED IN GROUP R-3 OR R-4 CONGREGATE RESIDENCES WITH 16 OR FEWER residents.

SPRINKLER SYSTEMS PER STATE OF MISSOURI DEPARTMENT OF HEALTH AND SENIOR SERVICES, CHAPTER 86 - RESIDENTIAL CARE FACILITIES & ASSISTED LIVING FACILITIES, SPRINKLER SYSTEM TO BE NFPA 13.

- SECTION 907.2.11.2 SMOKE ALARMS A SINGLE- OR MULTIPLE-STATION SMOKE ALARM SHALL BE INSTALLED AND MAINTAINED IN GROUP R-4 REGARDLESS OF OCCUPANT LOAD AT LOCATIONS PRESCRIBED IN THIS SECTION.
- SECTION 907.2.11.3 INTERCONNECTION "WHERE MORE THAN ONE SMOKE ALARM IS REQUIRED TO BE INSTALLED WITHIN AN INDIVIDUAL DWELLING UNIT OR SLEEPING UNIT IN GROUP R..., THE SMOKE ALARMS SHALL BE INTERCONNECTED IN SUCH A MANNER THAT THE ACTIVATION OF ONE ALARM WILL ACTIVATE ALL OF THE ALARMS IN THE INDIVIDUAL UNIT...".
- SECTION 907.2.11.4 POWER SOURCE "IN NEW CONSTRUCTION, REQUIRED SMOKE ALARMS SHALL RECEIVE THEIR PRIMARY POWER FROM THE BUILDING WIRING WHERE SUCH WIRING IS SERVED FROM A COMMERCIAL SOURCE AND SHALL BE EQUIPPED WITH A BATTERY BACKUP...".

### CHAPTER 10 - MEANS OF EGRESS:

SECTION 1002 – DEFINITIONS

SECTION 1006 MEANS OF EGRESS ILLUMINATION. - MEANS OF EGRESS, INCLUDING EXIT DISCHARGE SHALL BE ILLUMINATED AT ALL TIMES. MINIMUM 1 FOOT-CANDLE. 90 MINUTE EMERGENCY POWER TO BE PROVIDED.

# CODE REVIEW

### NN ON THE DOCUMENTS THAT MANCHESTER. THE FOLLOWING -

ILDING CODE

CAL CODE

CAL CODE CHANICAL CODE

Y EMS & FIRE PROTECTION 

IDENTIAL

REQUIREMENTS FOR XCEPT AS OTHERWISE PROVIDED

ND OCCUPANCY:

SAME BUILDING AND WALLS CCVPANCIES... SHALL BE ANCE WITH SECTION 708."

PER SECTION 903.2.8

reas

NTS FOR BUILDING ELEMENTS

<u>URES:</u>

.. (FOR FIRE PARTITIONS)

AVE 1/2 HR RATING PER TABLE


TOP OF FOUNDATION TO THE ESISTANCE-RATED ROOF/CEILING ATTACHED THERETO. THE SPACE BETWEEN THE CEILING KED OR DRAFTSTOPPED.

SUBDIVIDE ATTIC SPACES AND NS PRESCRIBED IN SECTIONS 718.4.2

ITICS AND CONCEALED ROOF A DOES NOT EXCEED 3,000 SQUARE

MATERIALS ELOPED 0-450 /ELOPED 0-450

- GROSS FLOOR AREA INCLUDES AREA INSIDE PERIMETER OF EXTERIOR WALLS.

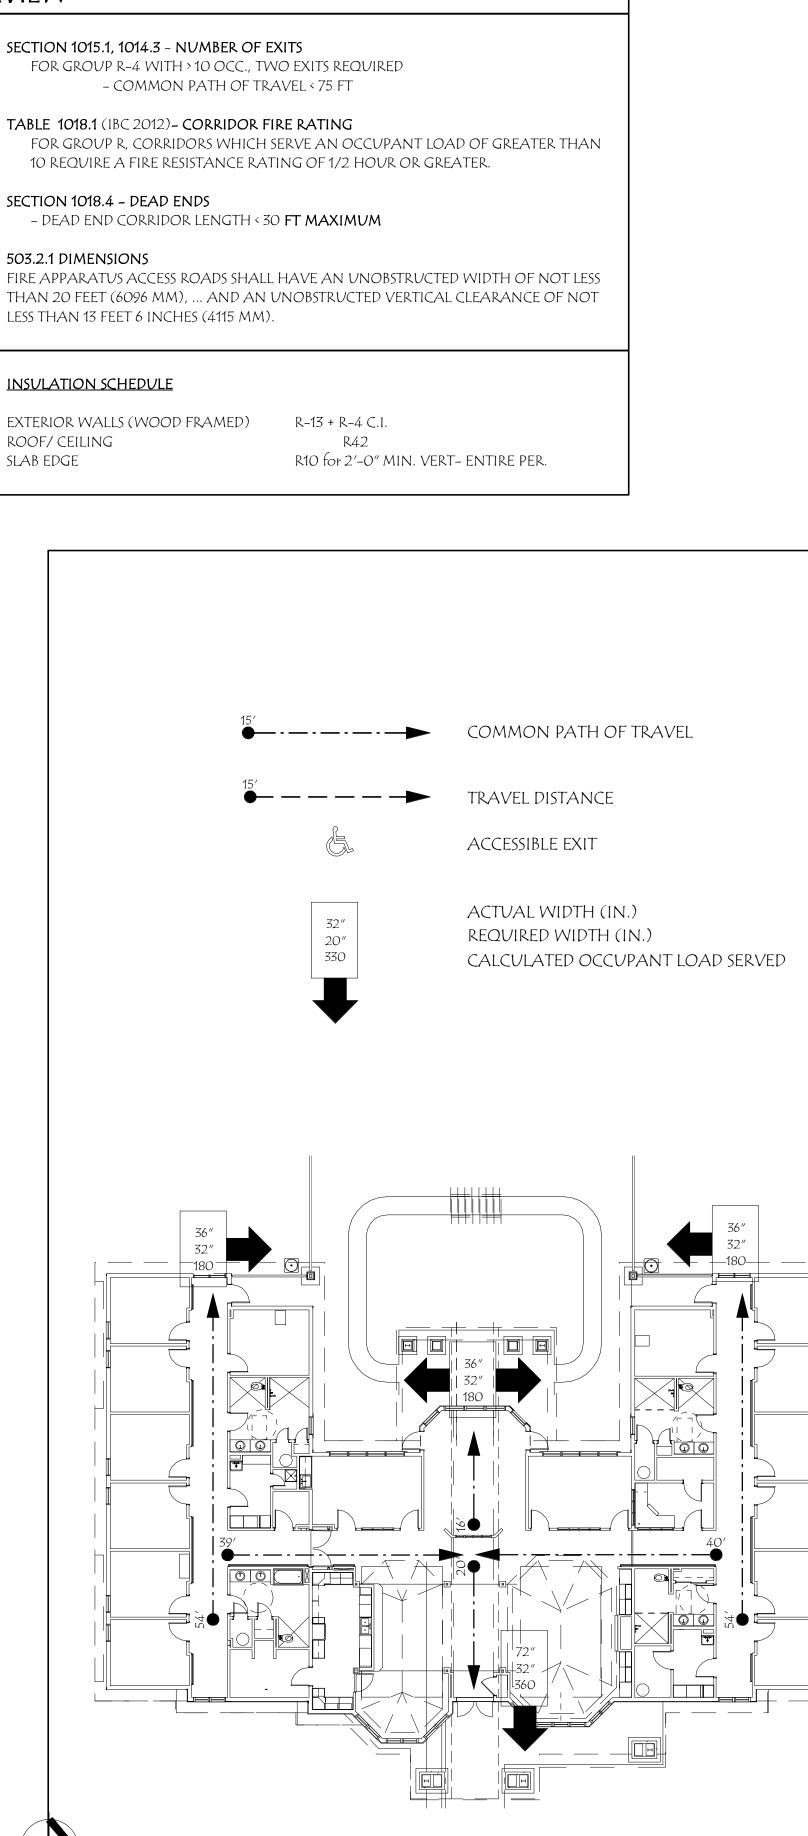


LIFE SAFETY PLAN


1/16" = 1'-0"


NORTH




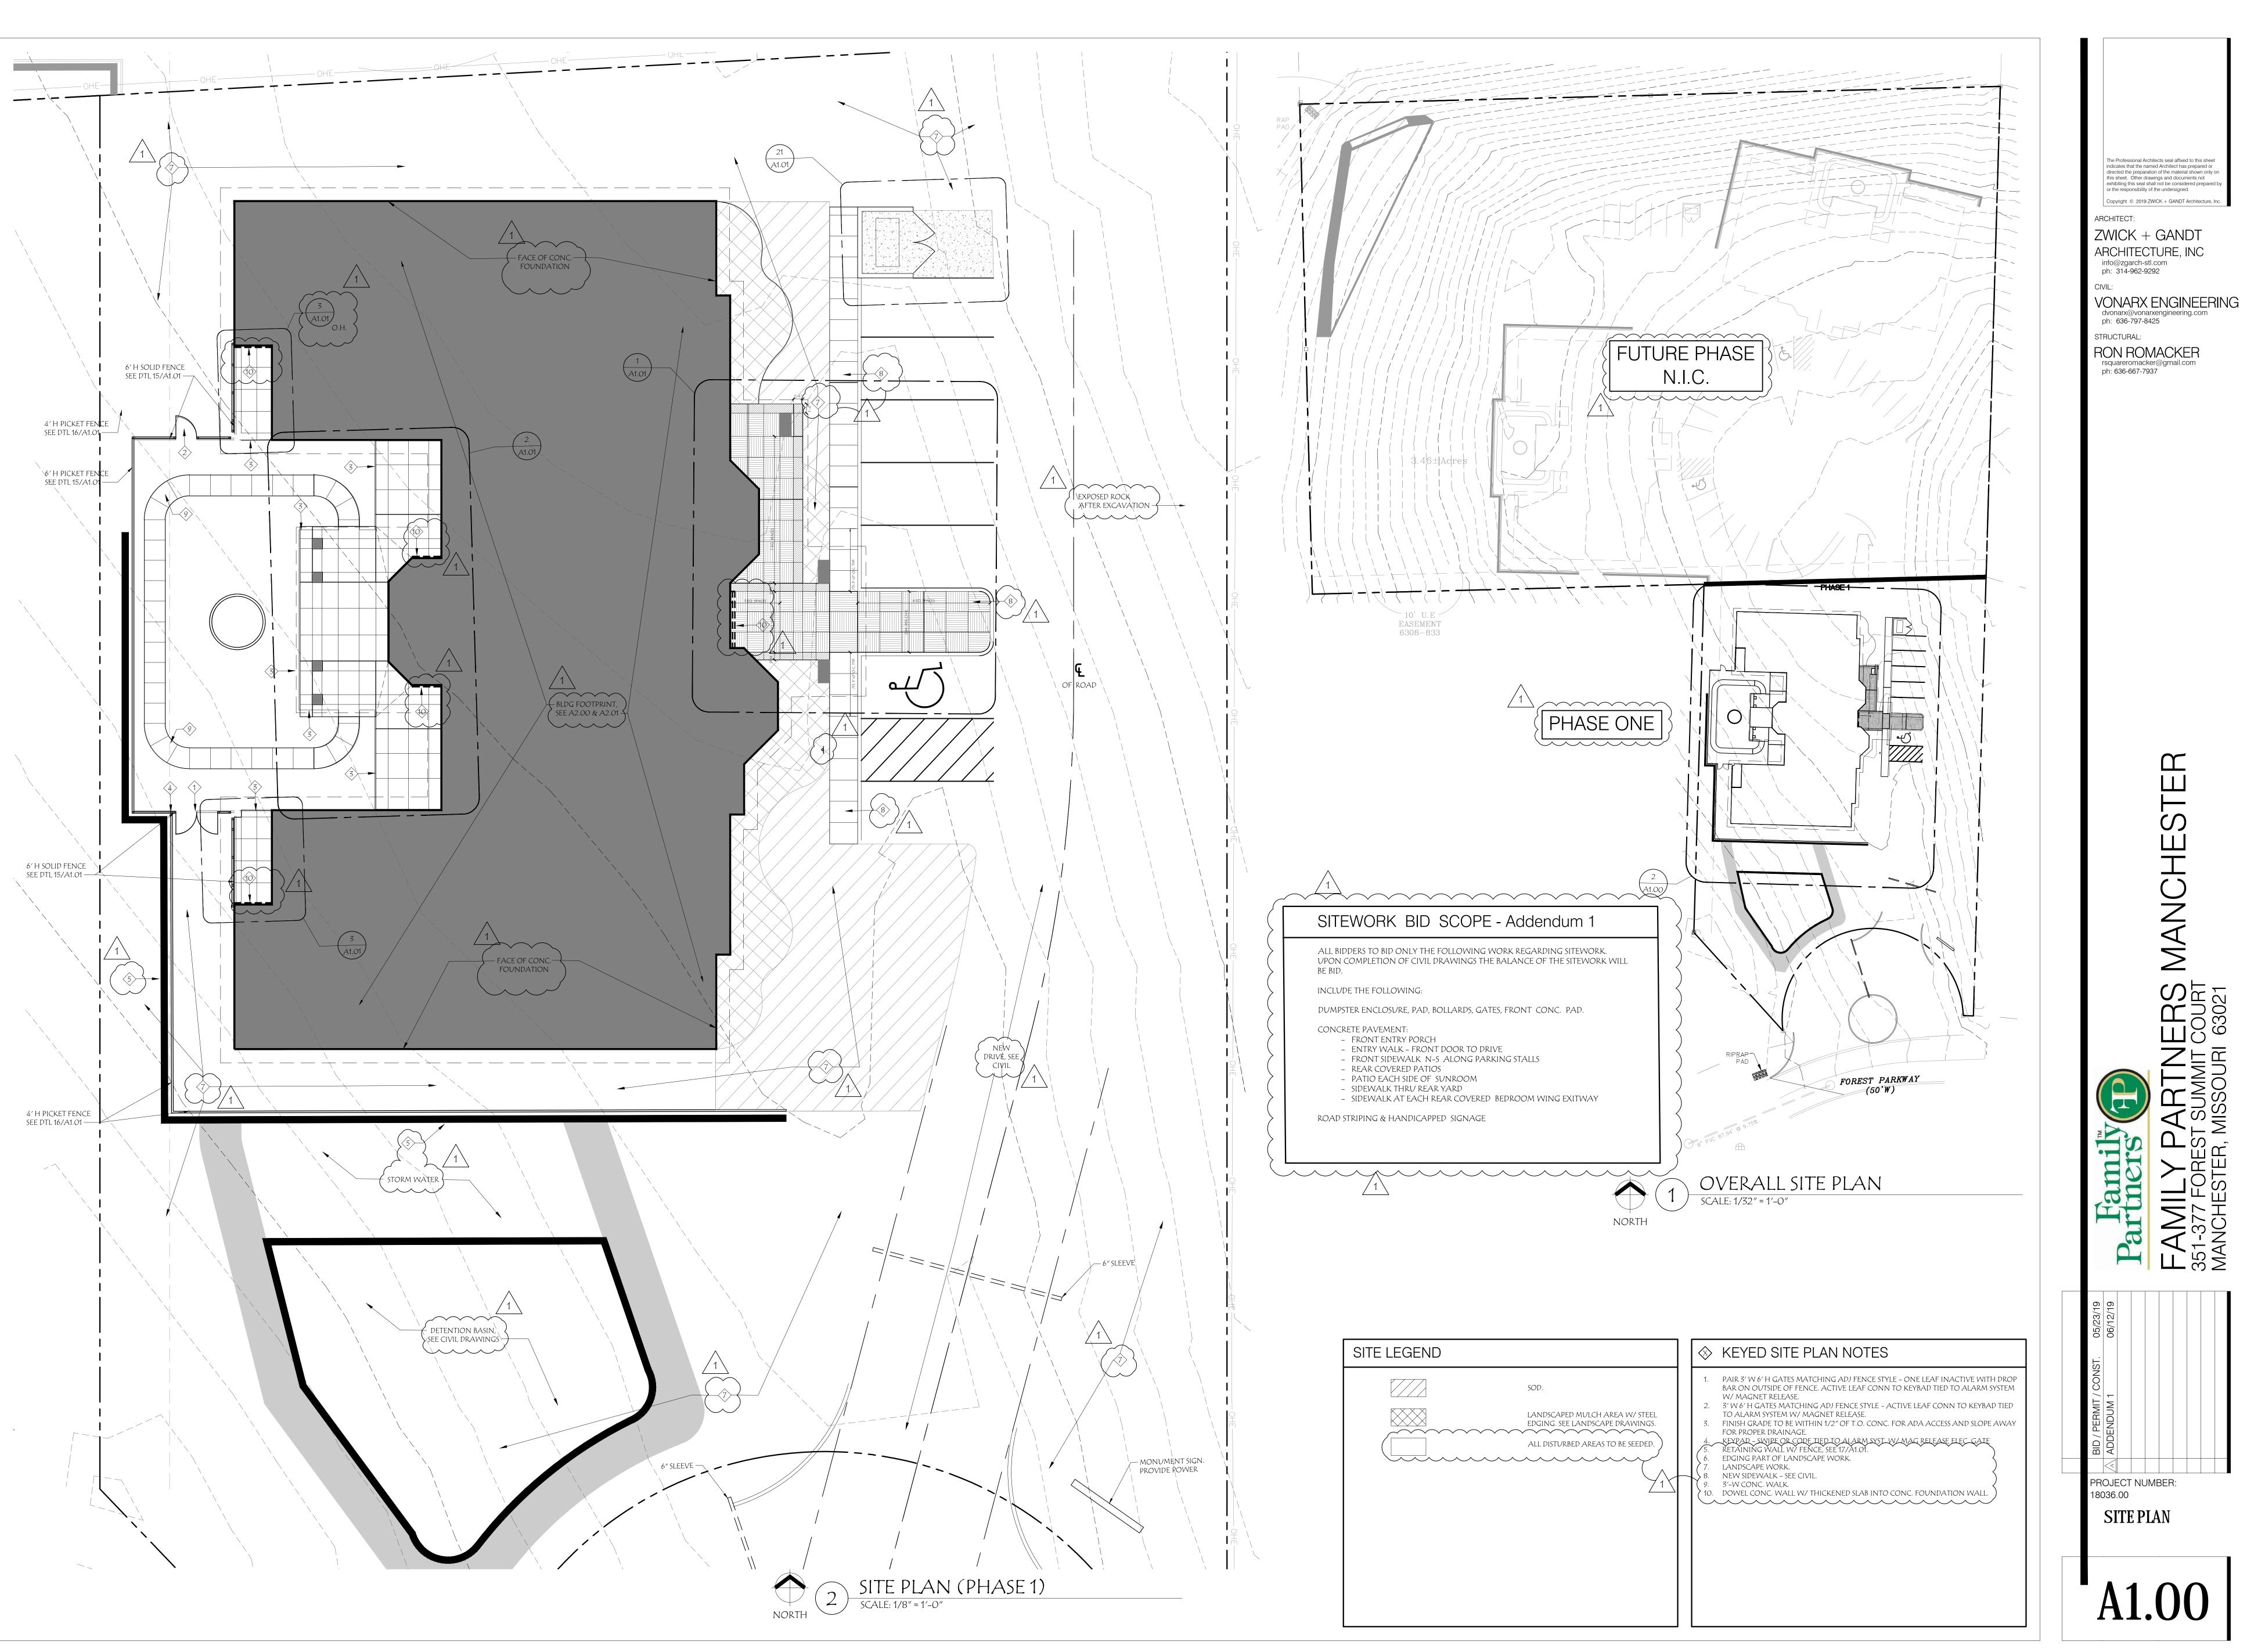


SITE LEGEND	♦ KEYED SITE PLAN NOTES
SOD.	<ol> <li>PAIR 3' W 6' H GATES MATCHING ADJ FENCE STYLE - ONE LEAF INACTIVE WITH DR</li></ol>
LANDSCAPED MULCH AREA W/ STEEL	BAR ON OVTSIDE OF FENCE. ACTIVE LEAF CONN TO KEYBAD TIED TO ALARM SYSTE
EDGING. SEE LANDSCAPE DRAWINGS.	W/ MAGNET RELEASE. <li>3' W 6' H GATES MATCHING ADJ FENCE STYLE - ACTIVE LEAF CONN TO KEYBAD TIE</li>
ALL DISTURBED AREAS TO BE SEEDED.	TO ALARM SYSTEM W/ MAGNET RELEASE. <li>FINISH GRADE TO BE WITHIN 1/2" OF T.O. CONC. FOR ADA ACCESS AND SLOPE AW</li>
1	FOR PROPER DRAINAGE. <li>KEYZAD. SWIPE OR CODE TLED TO ALARM SYST W/ MAG BELEASE FLEC GATE</li> <li>RETAINING WALL W/ FENCE, SEE 17/A1.01.</li> <li>EDGING PART OF LANDSCAPE WORK.</li> <li>LANDSCAPE WORK.</li> <li>NEW SIDEWALK - SEE CIVIL.</li> <li>3'-W CONC. WALK.</li> <li>DOWEL CONC. WALL W/ THICKENED SLAB INTO CONC. FOUNDATION WALL.</li>

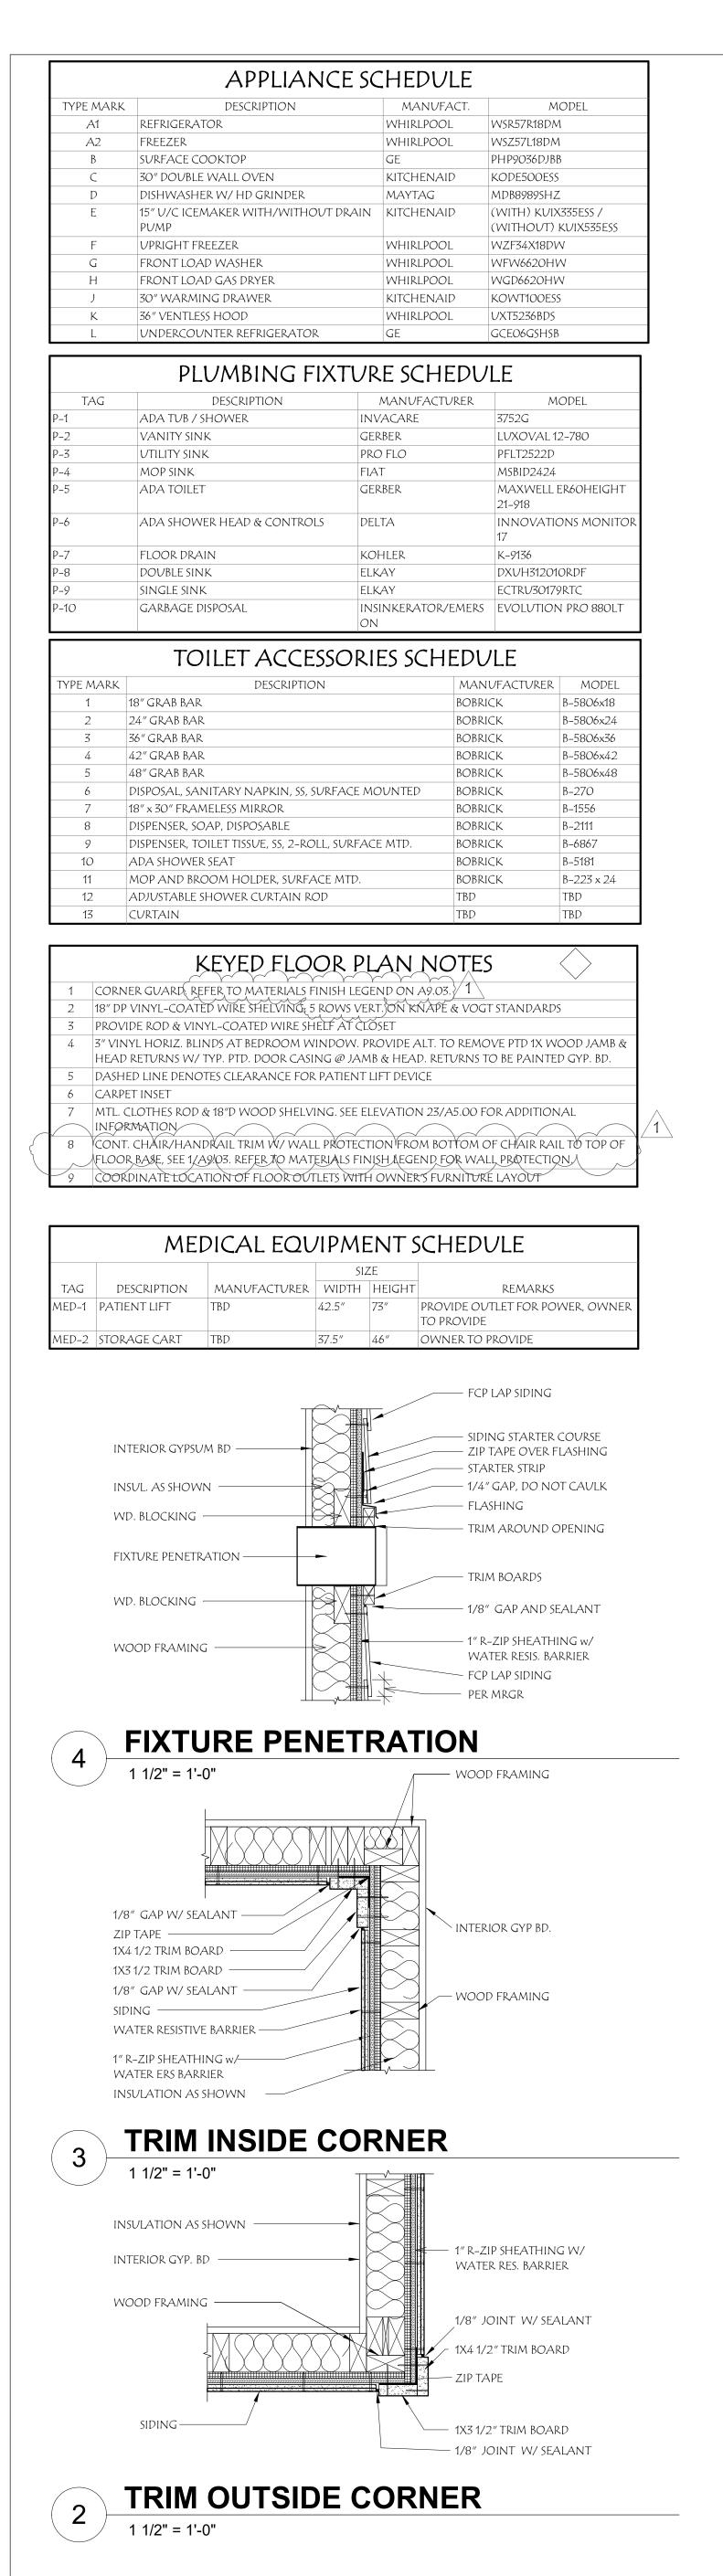

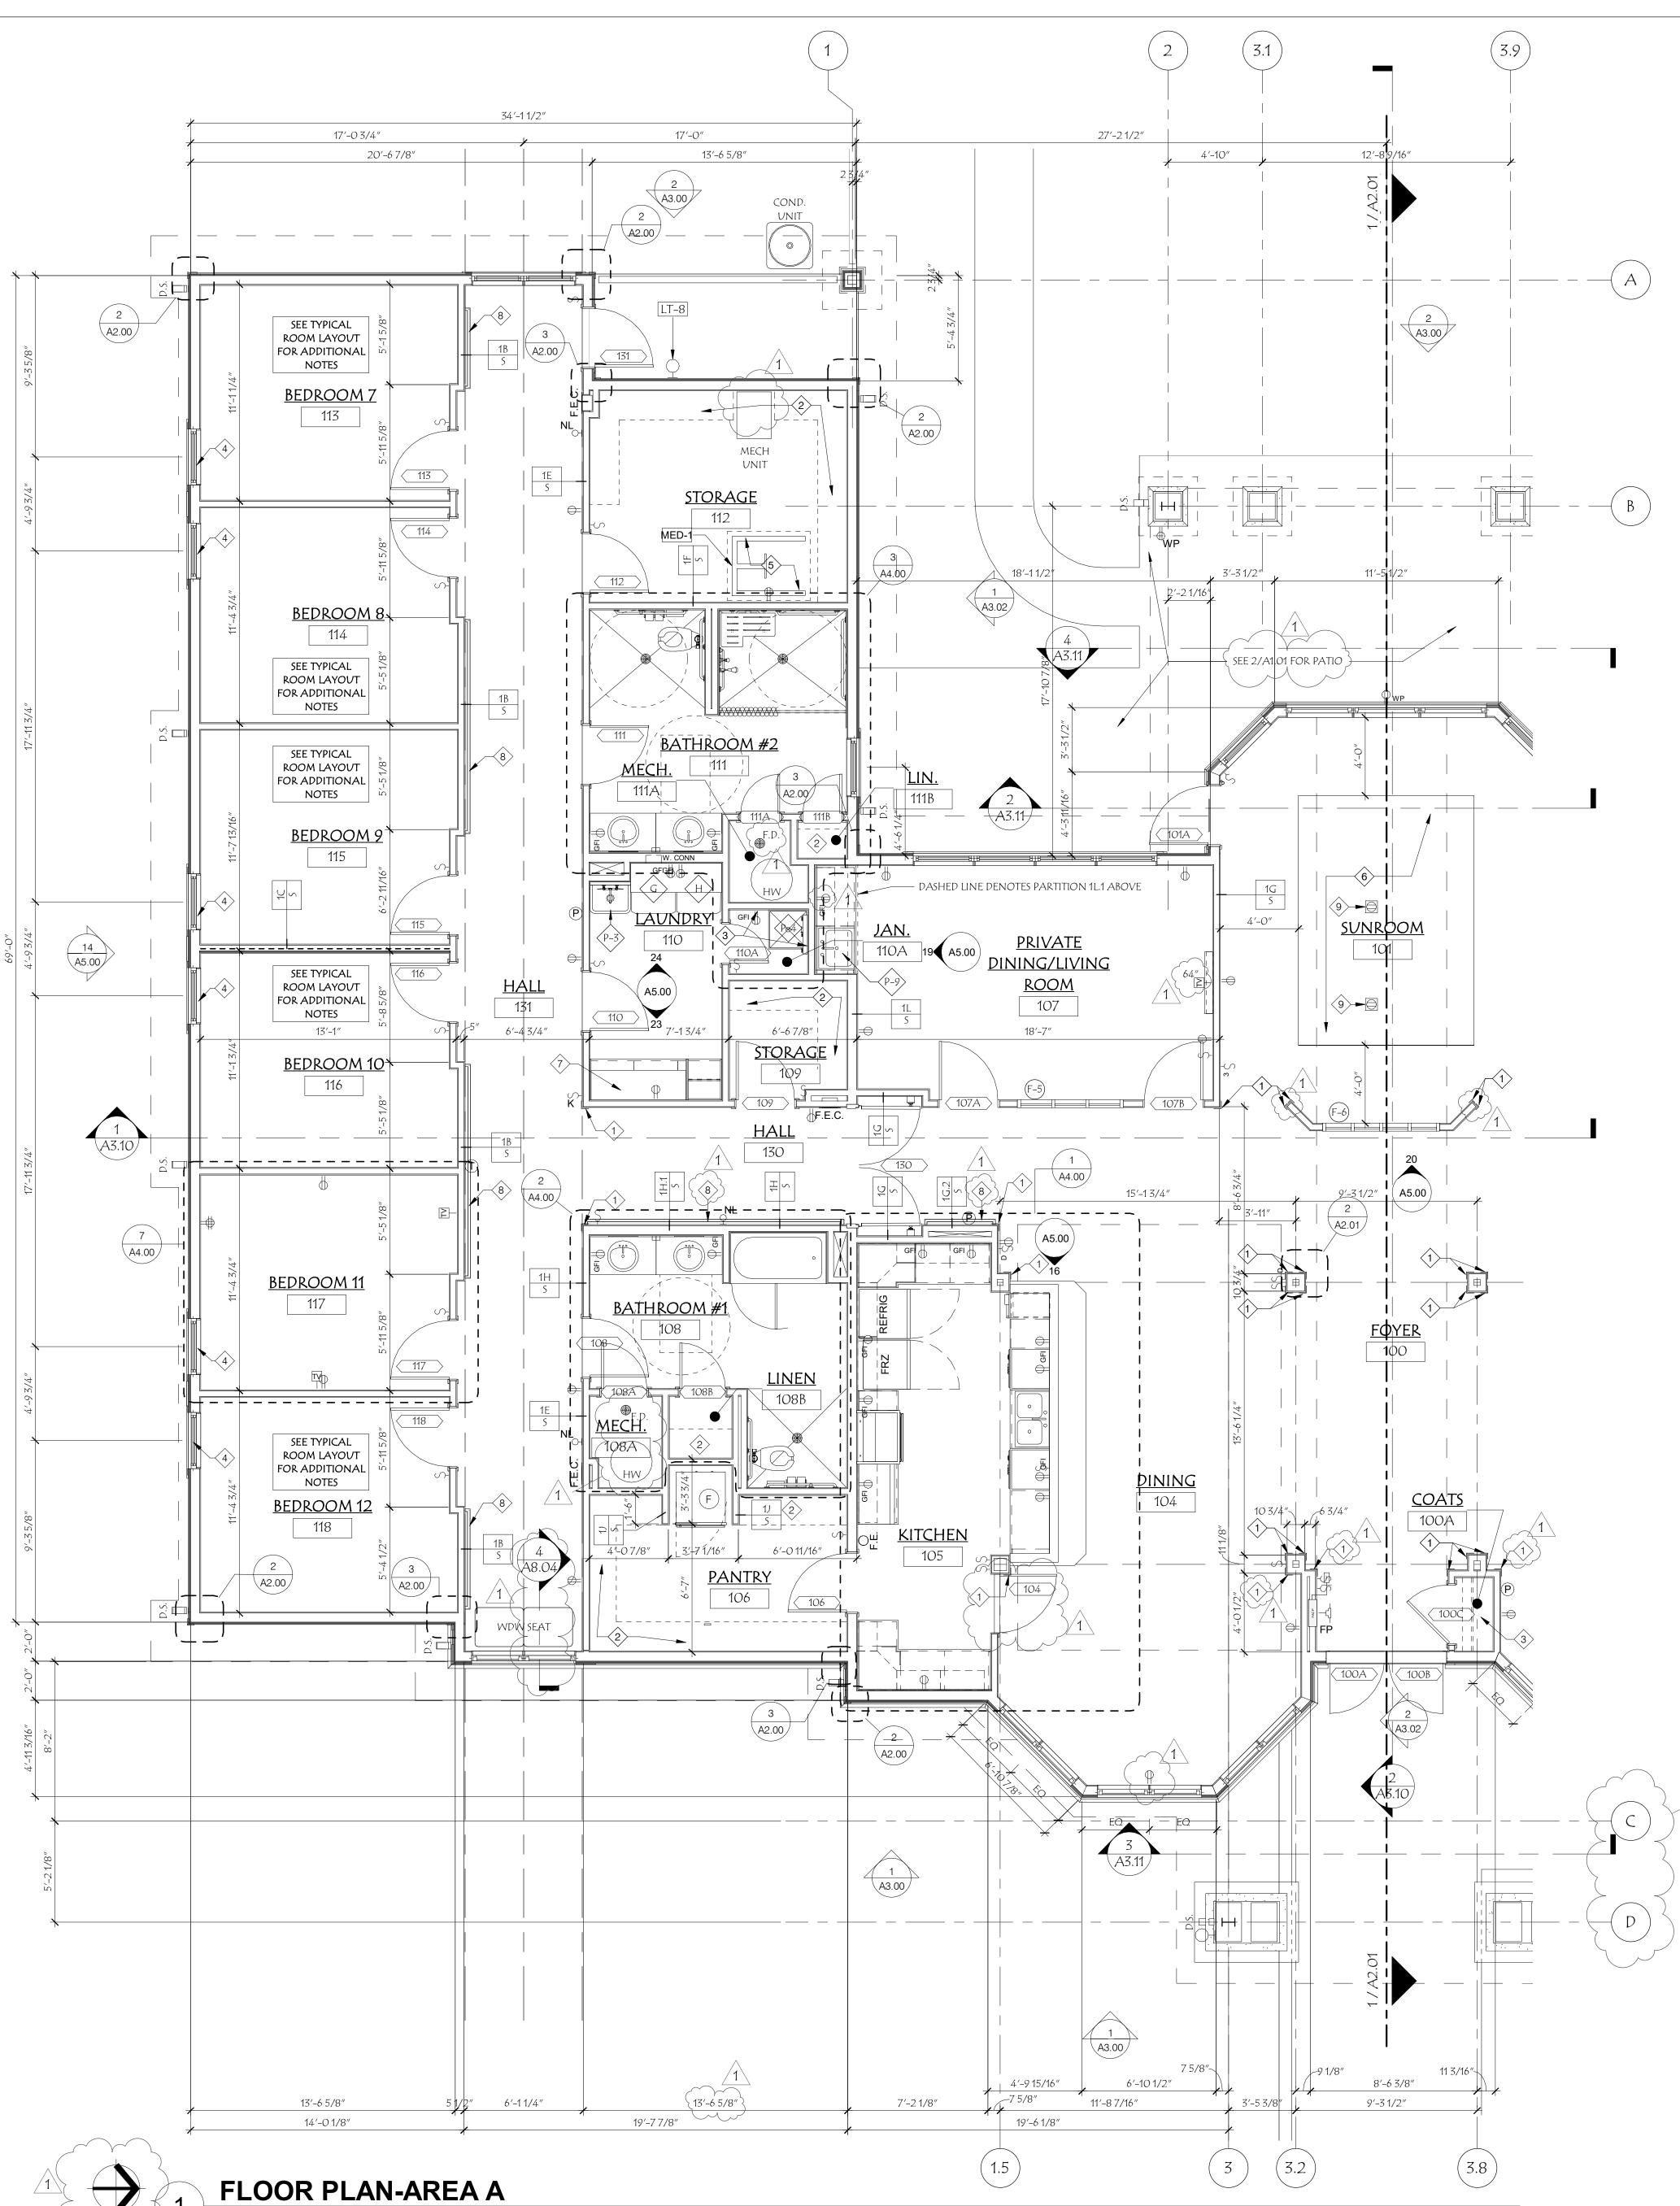

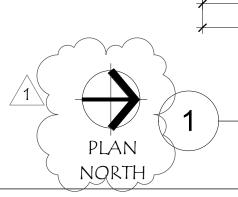

1/4" = 1'-0"

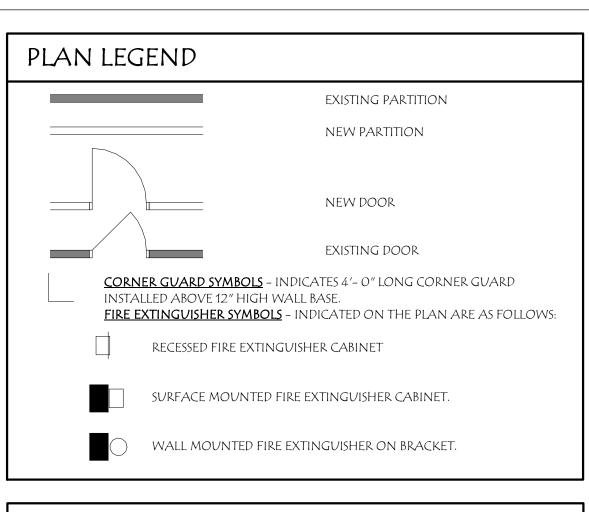

### ELEC. & FIRE EQPT. SYMBOL LEGEND


( ( )	DVPLEX OVTLET (TYP. @ 1'-6" A.F.F.)	W.V.	WALL VENT
$\Rightarrow$	ELEC. QUADPLEX OVTLET	$\overset{+}{\overset{-}{_{\rm NL}}}$	NITE LIGHT
TV	CABLE TV	$\bigcirc$	THERMOSTAT (@ 4'-6" A.F.F.)
\$	SWITCH (TYP. @ 4'-6" A.F.F.)	GFI	POWER OUTLET-GFI
\$	KEYED SWITCH	220v	220V OUTLET
W. CONN	WATER CONNECTION	FE	FIRE EXTING VISHER
P	EMERGENCY PULL-STATION	FP	FIRE PANEL
◀	TELEPHONE	$\triangleleft$	DATA
	NLL SYMBOLS ARE SHOWN FOR CLARITY &		

MECHANICAL, PLUMBING & ELECTRICAL SHEETS FOR EXACT LOCATIONS OF M.E.P. EQUIP & FIXTURES.

 $\underline{'E'}$  shown next to a symbol indicates that the fixture is existing to remain  $'\underline{N}'$  Shown Next to a symbol indicates that the fixture is New. '<u>R</u>' SHOWN NEXT TO A SYMBOL INDICATES THAT THE FIXTURE IS RELOCATED. '<u>#</u>' SHOWN NEXT TO A SYMBOL INDICATES THAT THE FIXTURE'S HEIGHT A.F.F. ALL HEIGHTS ARE CENTERLINE OF FIXTURE

- GENERAL FLOOR PLAN NOTES
- GENERAL CONTRACTOR AND / OR SUBCONTRACTORS ARE RESPONSIBLE FOR EXAMININ AND CONFIRMING ALL SUBSTRATE CONDITIONS WHERE NEW MATERIALS ARE APPLIED. SUBSTRATE SHALL BE SMOOTH, FREE OF DEFECTS AND SHALL CONFORM TO THE REOVIREMENTS OF THE FINISHED MATERIAL MANUFACTURERS' RECOMMENT DO NOT SCALE DRAWINGS. ALL DIMS TO BE FIELD VERIFIED. ARCHITECT TO BE NOTIFIED OF ANY DISCREPANCIES. THE WORD "ALIGN" AS USED IN THESE DOCS SHALL SUPERCEDE ANY DIMENSIONAL INFO INDICATED. IF DISCREPANCIES OCCUR, NOTIFY THE ARCHITECT IMMEDIATELY. TYPICAL DIMENSIONS ARE TO THE FACE OF WOOD STUD, OR TO COLUMN CENTER LINE. REFER TO PLAN DETAILS FOR ADDITIONAL DIMENSIONS. ALL ANGLES SHOWN ARE 45°, 90°, OR 135° UNLESS NOTED OTHERWISE. DO NOT SCALE THE DRAWINGS. WORKING FROM ESTABLISHED LINES AND POINTS, ESTABLISH AND MAINTAIN DEPENDABLE MARKERS FOR LINES AND LEVELS OF WORK. CALCULATE DIMS AND MEASURE FOR LAYOUT OF WORK. RECORD DEVIATIONS (IF ANY) FROM DWG INFO ON EXIST CONDITIONS AND REVIEW WITH ARCHITECT/ENGINEER AT TIME OF DISCOVERY FOLLOW WRITTEN DIMS AND LAYOUT POINTS ONLY. CONTRACTOR SHALL EXERCISE SPECIAL CARE IN THE VERIFICATION OF ALL CONDITIONS AND DIMS IN THE LAYOUT OF HIS WORK. THE ALIGNMENT IN COORDINATION OF HIS WORK ITSELF AND OTHER ADJACENT WORK IS OF PRIMARY IMPORTANCE AND SHALL TAKE PRECEDENCE OVER DIMENSIONS, ESPECIALLY THOSE INDICATED AS APPROXIMATE. CONTRACTOR SHALL LA OUT AND VERIFY HIS WORK TO ENSURE ALIGNMENT AND FIT AND REPORT ANY DISCREPANCIES IMMEDIATELY TO HIS SUPERINTENDENT AND THE ARCHITECT BEFORE PROCEEDING OR PROCEED AT CONTRACTOR'S OWN RISK SLOPING CONCRETE SLAB TO FLOOR DRAINS IS OF PRIMARY IMPORTANCE AND SHOULD fake precedence over dimensions, especially those indicated as approximate CONTRACTOR SHALL LAY OUT AND VERIFY HIS WORK TO ENSURE ALIGNMENT AND FIT, AND REPORT ANY DISCREPANCIES TO THE OWNER'S REPRESENTATIVE
- FHE GENERAL CONTRACTOR IS TO PROVIDE PROTECTION TO ANY COMPLETED WORK, ( CEILING GRID, ETC.) DURING CONSTRUCTION BY WHATEVER MEANS NECESSARY TO MAINTAIN ANY COMPLETED FINISHES IN NEW CONDITION TO THE POINT OF OWNER MOVE-IN AND ACCEPTANCE. ANY DAMAGED WORK, SCRATCHED, MARKED OR IN ANY WAY IMPAIRED MATERIAL FOUND BY THE OWNER'S REPRESENTATIVE WILL BE REPLACED AT NO EXTRA COST TO THE OWNER.
- ALL PARTITIONS INDICATED ON THE FLOOR PLAN TO BE TYPE XX/X-SW UNLESS NOTED OTHERWISE. SEE PARTITION TYPES ON SHEET AX.X FOR PARTITION MATERIALS, THICKNESS AND CONSTRUCTION REQUIREMENTS.
- ALL INTERIOR FINISHES AND INSULATION SYSTEMS TO HAVE A FLAME SPREAD INDEX OF NOT MORE THAN 25 AND A SMOKE DEVELOPED INDEX OF NOT MORE THAN 450. ALL CONTROL JOINTS IN GYP. BD. & PLASTER WALLS AND/ OR CLGS TO BE LOCATED AS REQ. BY U.S. GYPSUM U.N.O.FOR INT. AND EXT. LOCATIONS. FINAL JOINT LOCATIONS ARE TO BE REVIEWED WITH ARCHITECT PRIOR TO INSTALL.
- PROVIDE BITUMINOUS COATING BETWEEN ALL DISSIMILAR METALS. ALL WOOD IN DIRECT CONTACT WITH CONCRETE TO BE PRESERVATIVE ROT RESISTANT
- TREATED WOOD V.N.O. ALL FOUNDATION WALLS IN EXCAVATED AREAS TO BEAR ON AND BE FORMED BY
- CLEANED, UNDISTURBED, VIRGIN SUB-SOIL. SEE SOILS REPORT AND STRUCT. DWGS FOR FOR SOIL PREP WORK AND ANTICIPATED CONDITIONS
- WHERE DOWELING THE SIDEWALK SLAB INTO THE FDN. IS NOT SHOWN: INSTALL LEAN CONC. FILL TO A DEPTH BELOW FROST AT BLDG ENTRANCES TO PREVENT FROST HEAVE OF SIDEWALK SLABS BELOW DOOR OPENINGS
- IT WILL BE THE RESPONSIBILITY OF THE GENERAL CONTRACTOR TO HAVE ALL ELECTRICA REQUIREMENTS FOR FIRE PROTECTION, PLUMBING AND MECHANICAL WORK COORDINATED WITH THE ELECTRICAL CONTRACTOR FOR ALL AREAS OF THE WORK WHETHER SHOWN ON THE DRAWINGS OR NOT - AT NO EXTRA COST TO THE OWNER.
- ALL PENETRATIONS THROUGH RATED PARTITIONS (MECH., ELEC., AND PLUMB.) TO BE FILLED WITH FIRE SAFING INSUL AND FIRE STOP'G SEALANT PER UL DESIGNS INDICATED. ALL PARTITIONS ARE 1A/S UNLESS OTHERWISE NOTED

### KEY PLAN

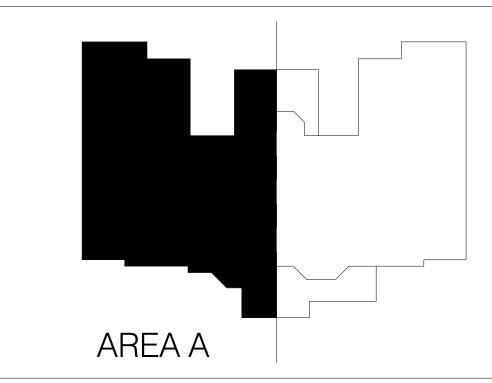



	APPLIANCE SC	HEDVLE	
TYPE MARK	DESCRIPTION	MANUFACT.	MODEL
A1	REFRIGERATOR	WHIRLPOOL	WSR57R18DM
A2	FREEZER	WHIRLPOOL	WSZ57L18DM
В	SVRFACE COOKTOP	GE	РНР9036DJBB
С	30" DOUBLE WALL OVEN	KITCHENAID	KODE500ESS
D	DISHWASHER W/ HD GRINDER	MAYTAG	MDB8989SHZ
E	15" U/C ICEMAKER WITH/WITHOUT DRAIN PUMP	KITCHENAID	(WITH) KUIX335ESS / (WITHOUT) KUIX535ESS
F	VPRIGHT FREEZER	WHIRLPOOL	WZF34X18DW
G	FRONT LOAD WASHER	WHIRLPOOL	WFW6620HW
Н	FRONT LOAD GAS DRYER	WHIRLPOOL	WGD6620HW
J	30" WARMING DRAWER	KITCHENAID	KOWT100ESS
К	36" VENTLESS HOOD	WHIRLPOOL	UXT5236BDS
L	UNDERCOUNTER REFRIGERATOR	GE	GCEO6GSHSB


TAG	DESCRIPTION	MANVFACTURER	MODEL
P-1	ADA TUB / SHOWER	INVACARE	3752G
P-2	VANITY SINK	GERBER	LVXOVAL 12-780
P-3	UTILITY SINK	PRO FLO	PFLT2522D
P-4	MOP SINK	FIAT	MSBID2424
P-5	ADA TOILET	GERBER	MAXWELL ER60HEIGHT 21-918
P-6	ADA SHOWER HEAD & CONTROLS	DELTA	INNOVATIONS MONITOR 17
P-7	FLOOR DRAIN	KOHLER	K-9136
P-8	DOVBLE SINK	Elkay	DXVH312010RDF
P-9	SINGLE SINK	Elkay	ECTRV30179RTC
P-10	GARBAGE DISPOSAL	INSINKERATOR/EMERS ON	EVOLUTION PRO 880LT

TOILET ACCESSORIES SCHEDULE								
TYPE MARK	DESCRIPTION	MANUFACTURER	MODEL					
1	18" GRAB BAR	BOBRICK	B-5806x18					
2	24" GRAB BAR	BOBRICK	B-5806x24					
3	36" GRAB BAR	BOBRICK	B-5806x36					
4	42" GRAB BAR	BOBRICK	B-5806x42					
5	48" GRAB BAR	BOBRICK	B-5806x48					
6	DISPOSAL, SANITARY NAPKIN, SS, SURFACE MOUNTED	BOBRICK	B-270					
7	18" x 30" FRAMELESS MIRROR	BOBRICK	B-1556					
8	DISPENSER, SOAP, DISPOSABLE	BOBRICK	B-2111					
9	DISPENSER, TOILET TISSUE, SS, 2-ROLL, SURFACE MTD.	BOBRICK	B-6867					
10	ADA SHOWER SEAT	BOBRICK	B-5181					
11	MOP AND BROOM HOLDER, SVRFACE MTD.	BOBRICK	B-223 x 24					
12	ADJUSTABLE SHOWER CURTAIN ROD	TBD	TBD					
13	CURTAIN	TBD	TBD					

## KEYED FLOOR PLAN NOTES

- CORNER GUARD REFER TO MATERIALS FINISH LEGEND ON A9.03. }/1 3" VINYL HORIZ. BLINDS AT BEDROOM WINDOW. PROVIDE ALT. TO REMOVE PTD 1X WOOD JAMB & HEAD RETURNS W/ TYP. PTD. DOOR CASING @ JAMB & HEAD. RETURNS TO BE PAINTED GYP. BD.
- PROVIDE ROD & VINYL-COATED WIRE SHELF AT CLOSET
- ALIGN EDGE OF ANGLED WOOD STUD TO PERRENDISULAR WOOD STUD 18" DP VINYL-COATED WIRE SHELVING 5 ROWS VERT. ON KNAPE & VOGT STANDARDS
- DASHED LINE DENOTES CLEARANCE FOR 24" x 36" MEDICAL STORAGE CART
- DASHED LINE DENOTES CLEARANCE FOR PATIENT LIFT DEVICE
- 3 CARPET INSET CONT. CHAIR/HANDRAIL TKIM W/ WALL PROTECTION FROM BOTTOM OF CHAIR RAIL TO TOPOF FLOOR BASE, SEE1/A9.03. REFER TO MATERIALS FINISH LEGEND FOR WALL PROTECTION.
- 9 COORDINATE LOCATION OF FLOOR OUTLETS WITH OWNER'S FURNITURE LAYOUT 11 MTL. CLOTHES ROD & 18"D WOOD SHELVING. SEE ELEVATION 23/A5.00 FOR ADDITIONAL INFORMATION
- 2 ELECTRICAL PANEL


MEDICAL EQVIPMENT SCHEDVLE										
			SIZ	ΖE						
TAG	DESCRIPTION	MANUFACTURER	WIDTH	HEIGHT	REMARKS					
MED-1	PATIENT LIFT	TBD	42.5″	73″	PROVIDE OUTLET FOR POWER, OWNER TO PROVIDE					
MED-2	STORAGE CART	TBD	37.5″	46″	OWNER TO PROVIDE					

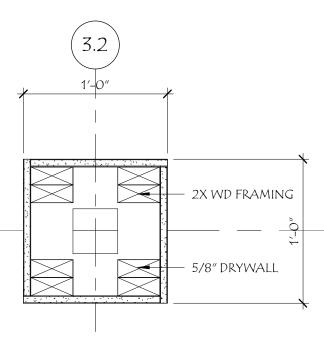







Plan

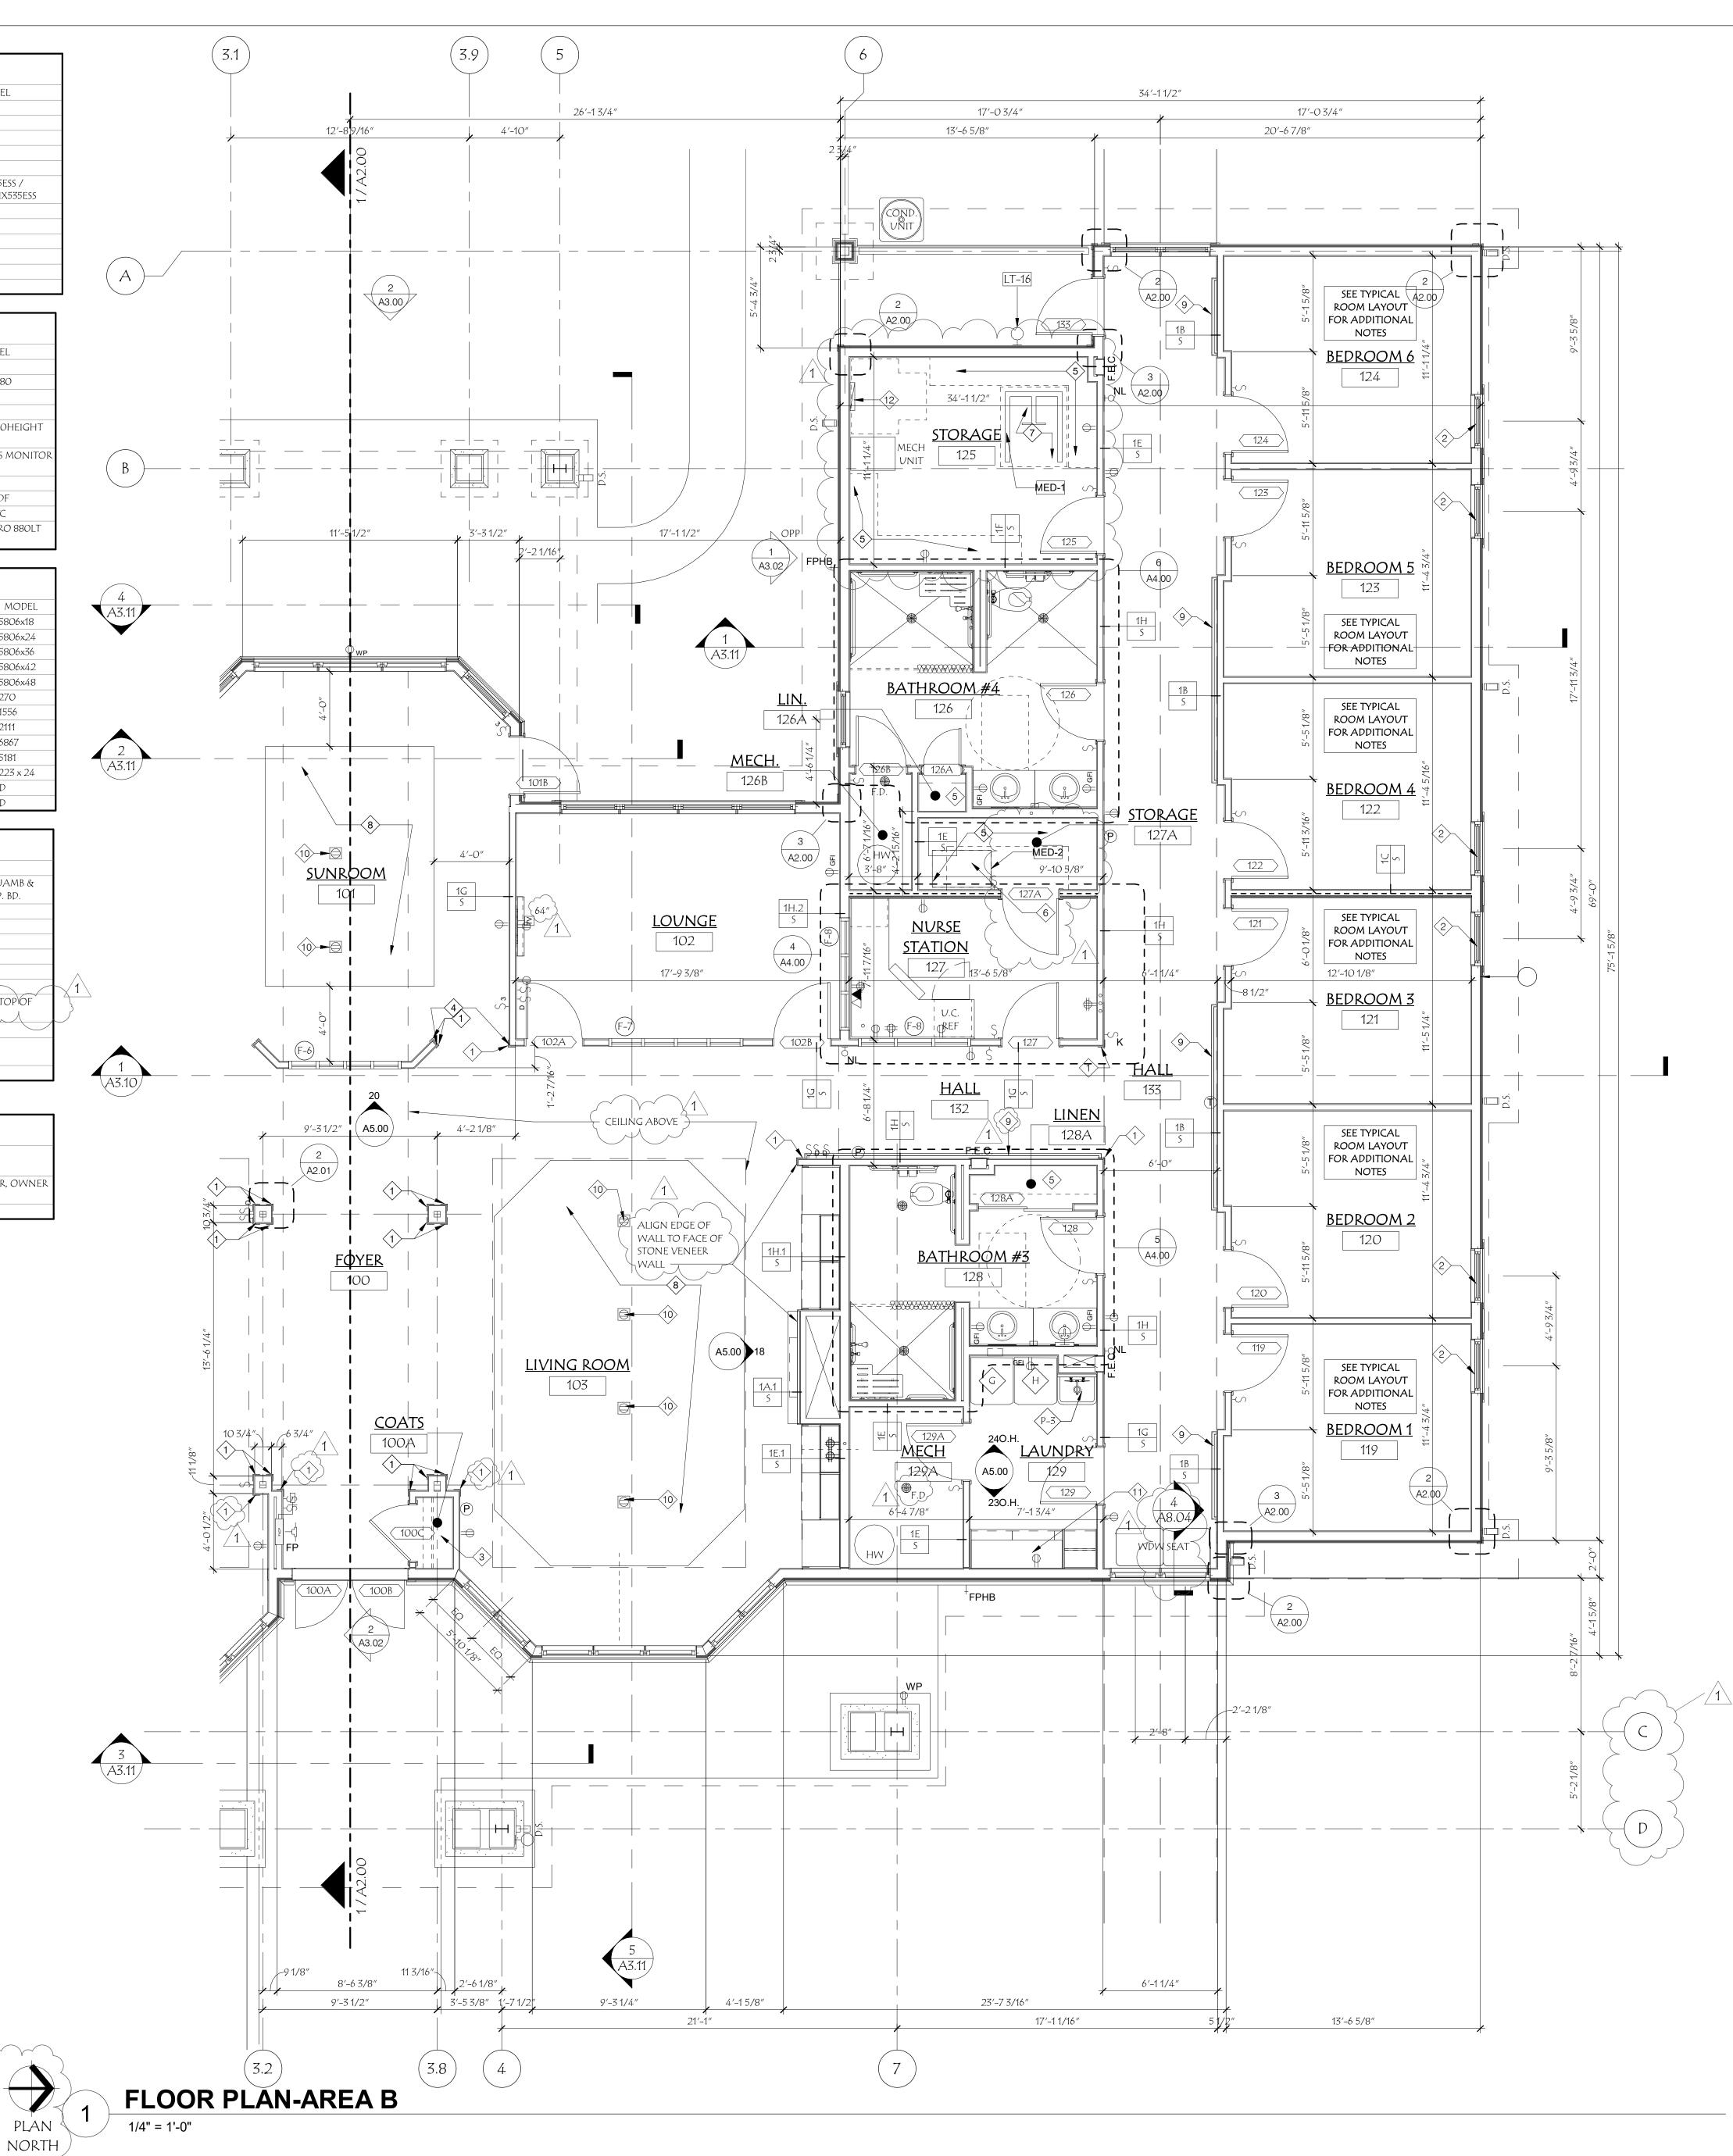

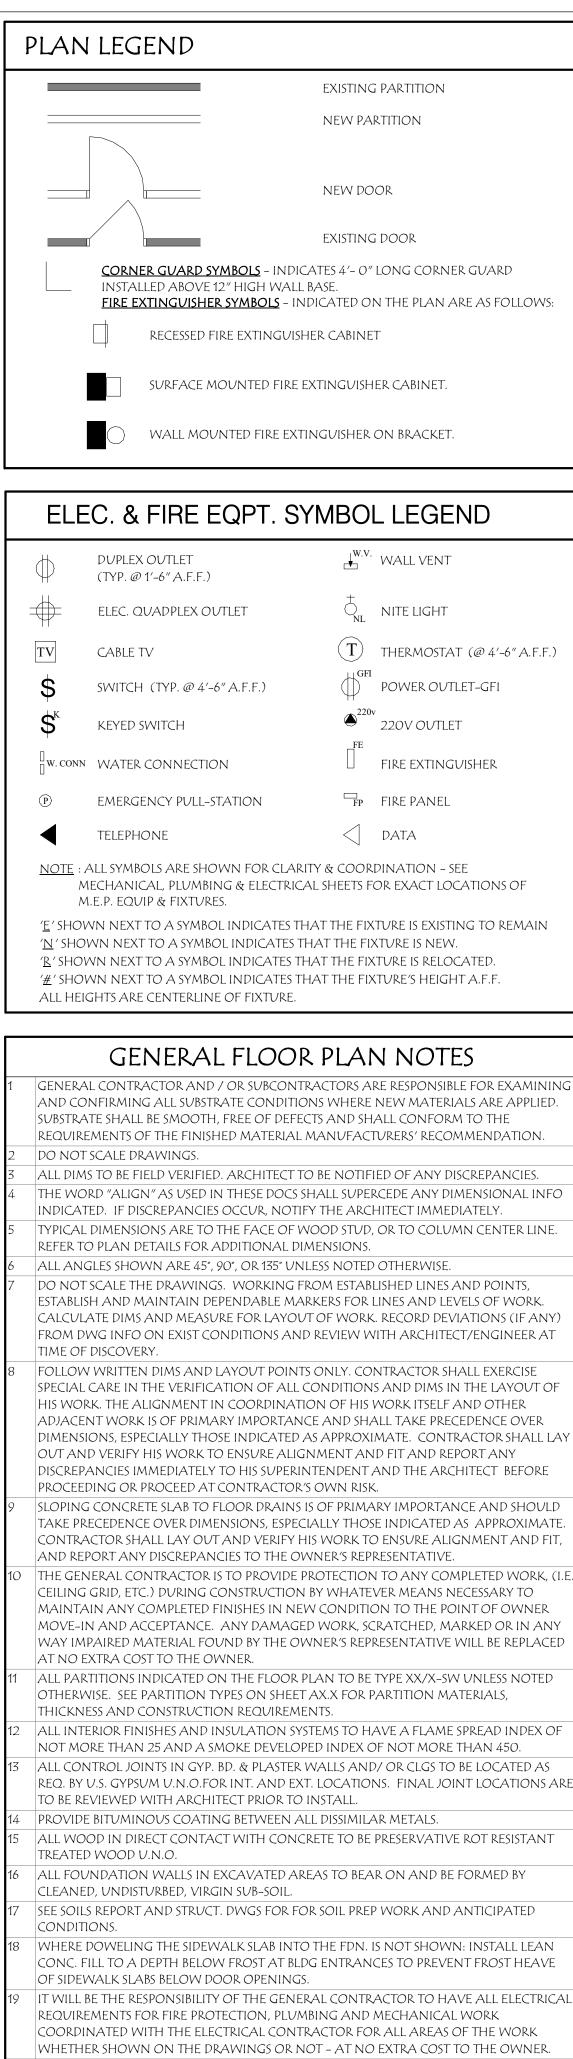


ALL PENETRATIONS THROUGH RATED PARTITIONS (MECH., ELEC., AND PLUMB.) TO BE FILLED WITH FIRE SAFING INSUL AND FIRE STOP'G SEALANT PER UL DESIGNS INDICATED. ALL PARTITIONS ARE 1A/S UNLESS OTHERWISE NOTED.

### KEY PLAN

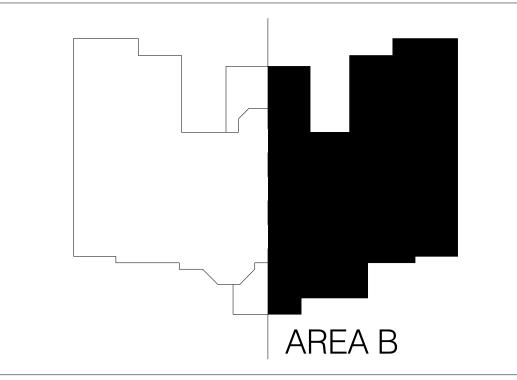




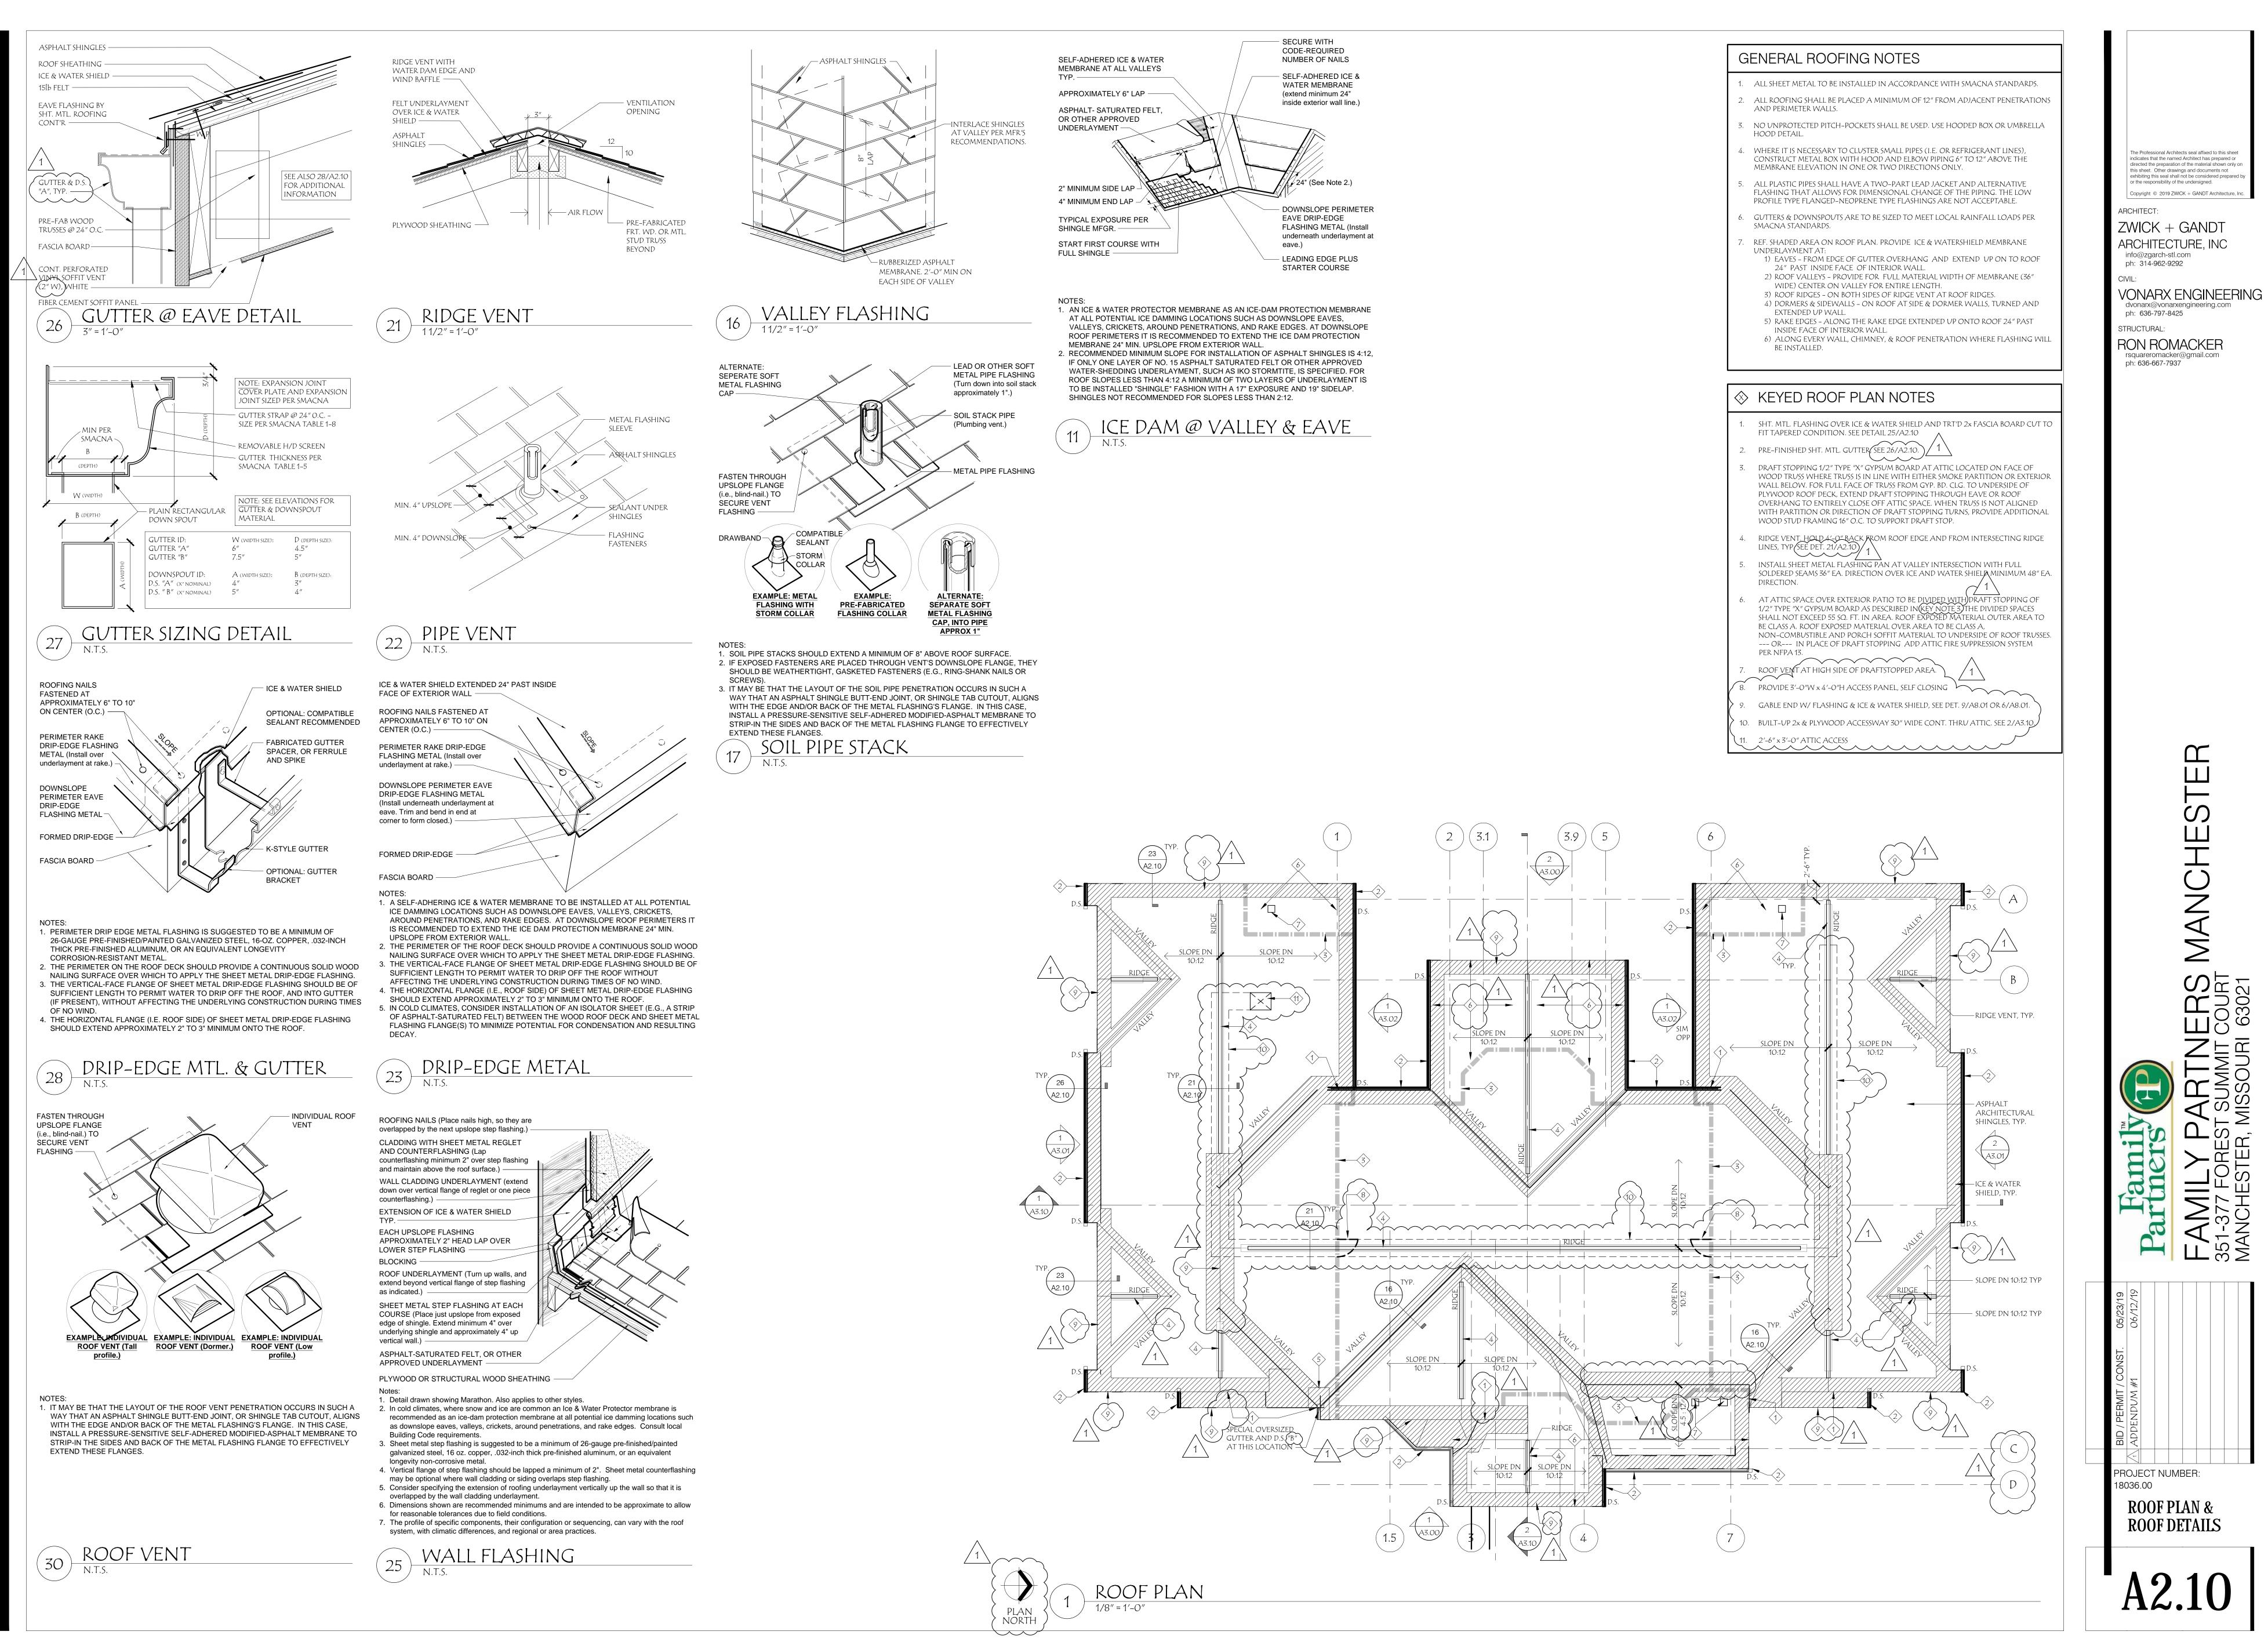







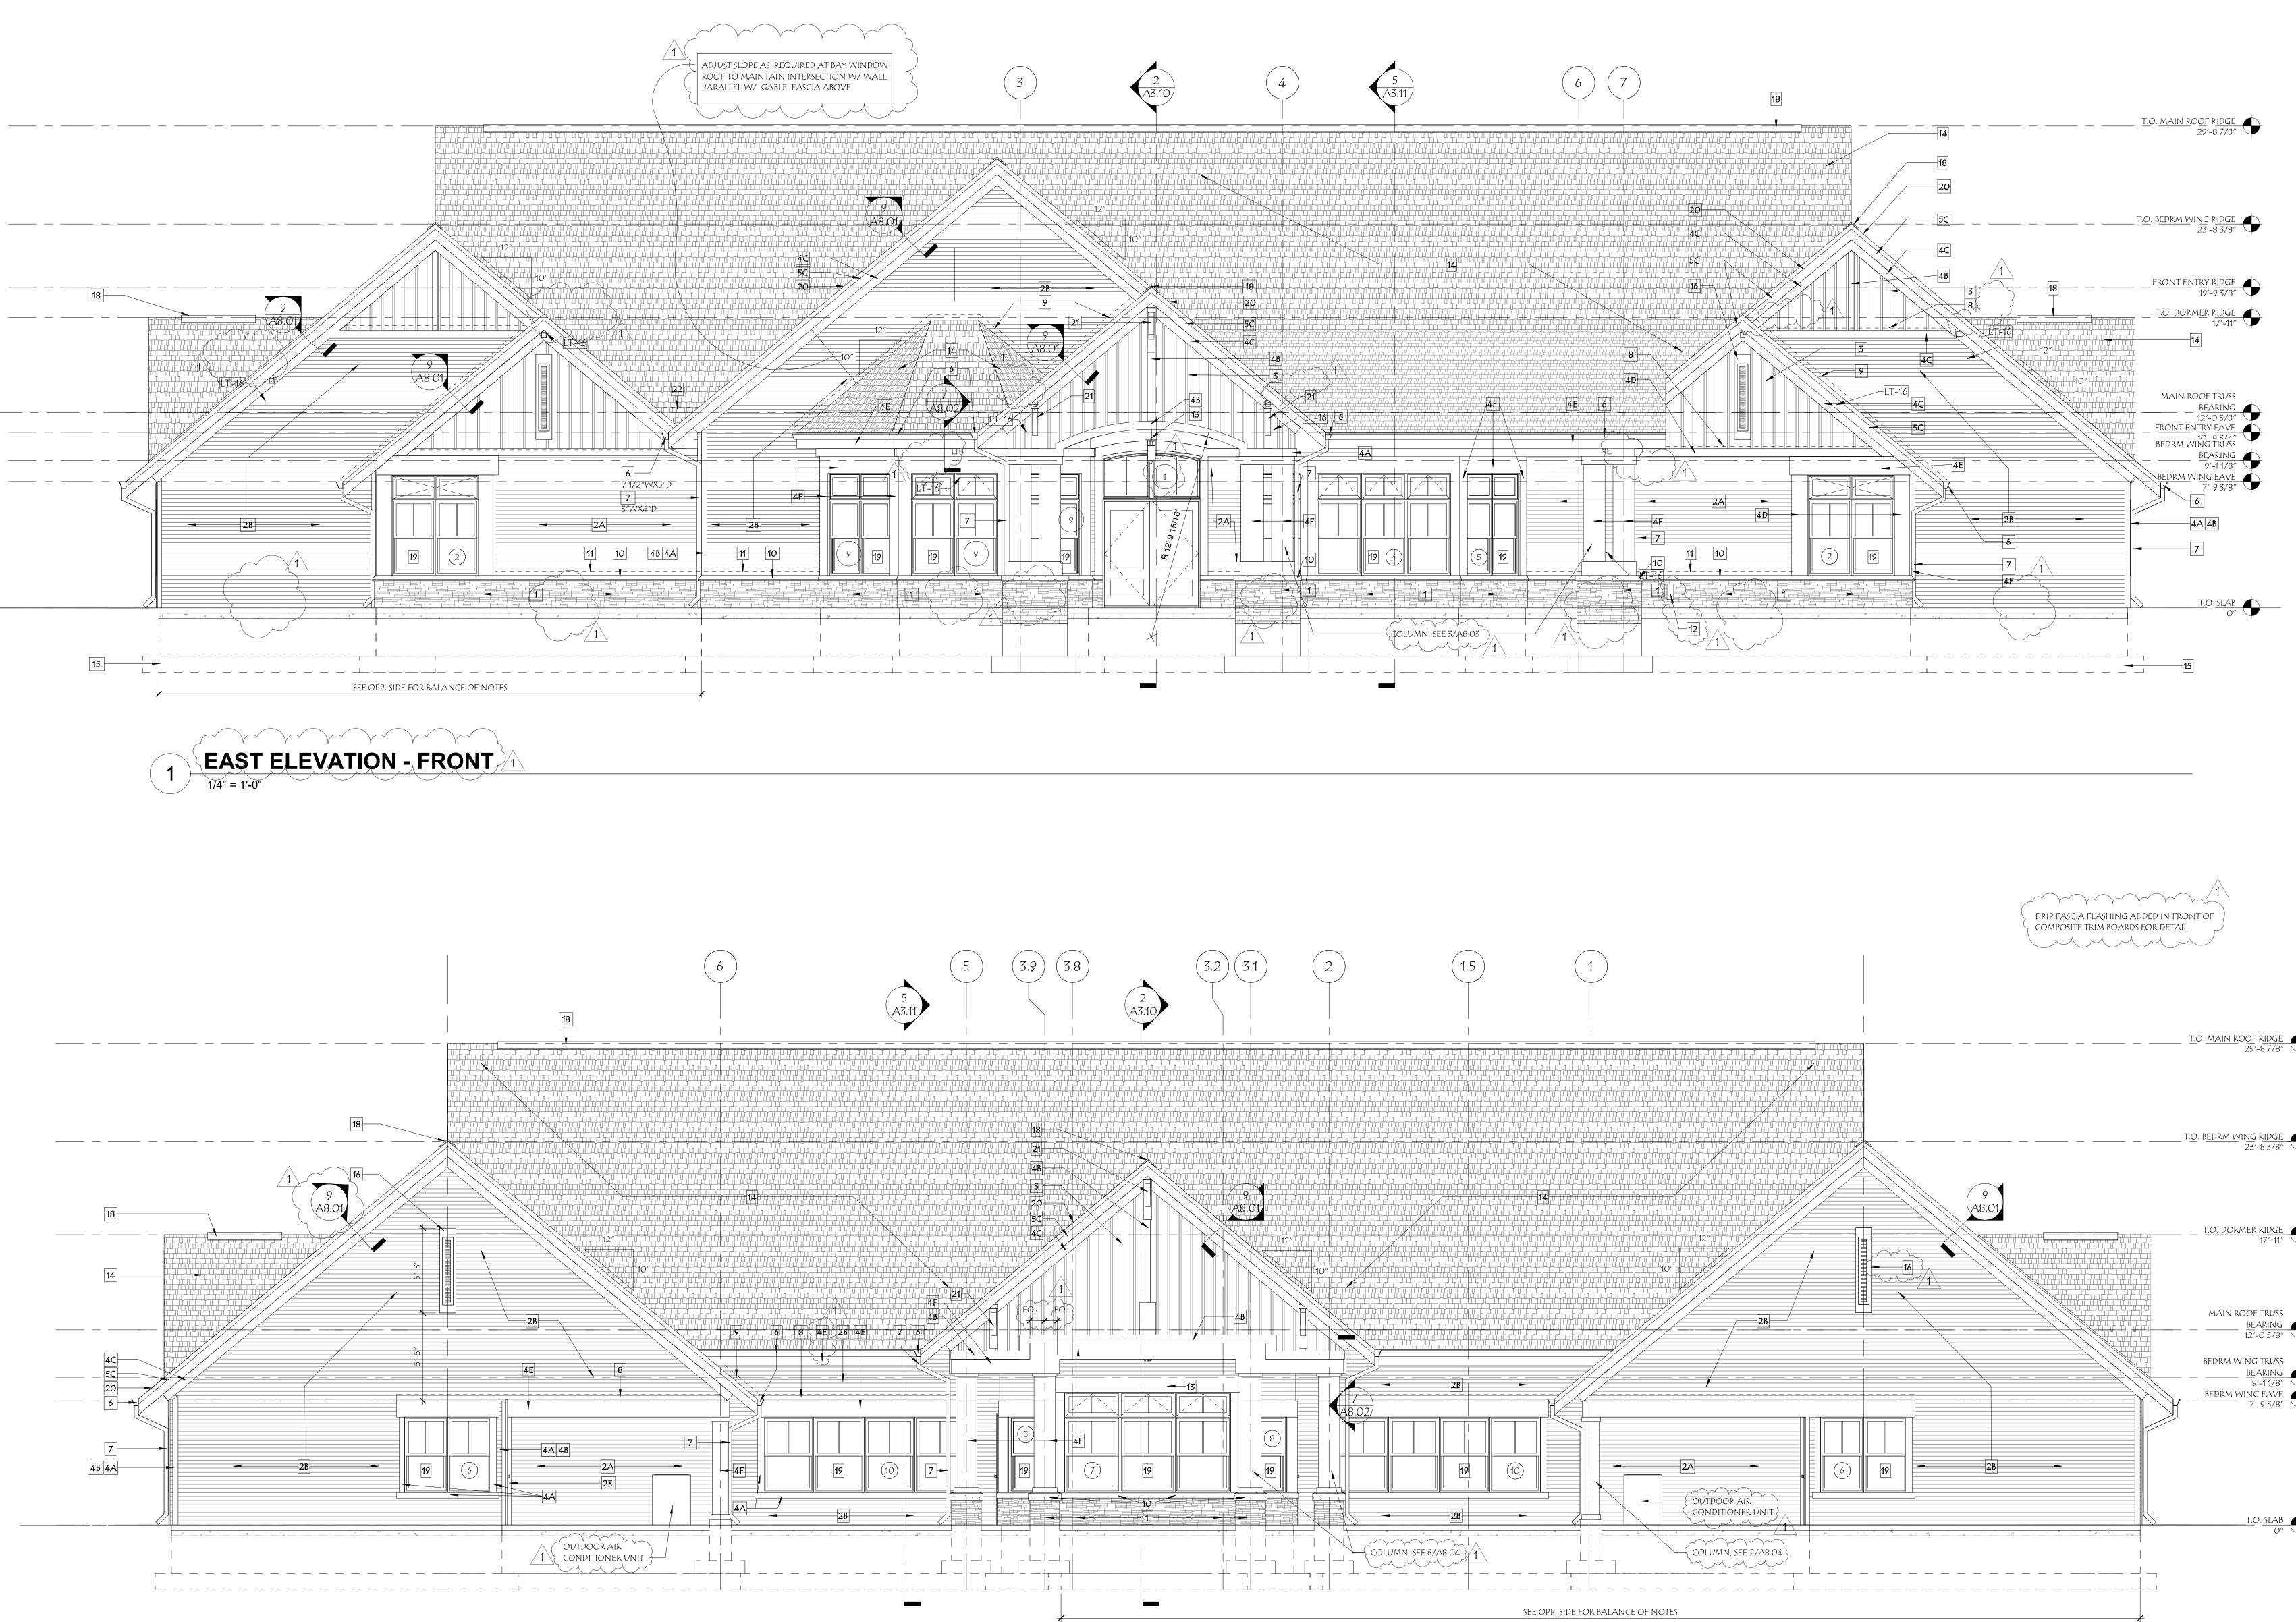







	MATERIAL		RIAL LEGEND	
		MANFACTURER		COLOR
2A  -	ADHERED STONE	CULTURED STONE	COBBLEFIELD, THIN SET STONE	TBD BY ARCHITECT
	HORIZONTAL LAP SIDING	JAMES HARDIE	CEDARMILL, 5" EXPOSURE	LIGHT MIST
2B H	HORIZONTAL LAP SIDING	JAMES HARDIE	CEDARMILL, 5" EXPOSURE	EVENING BLUE
3 V	/ERTICAL FIBER CEMENT SIDING	JAMES HARDIE	SMOOTH HARDIE PANEL SIDING WITH VERTICAL 3/4"X1 1/2" HARDIE BATTEN BOARDS 8" O.C.	LIGHT MIST
	5/4" X 3 1/2" COMPOSITE TRIM BOARD 1" ACTUAL)	JAMES HARDIE	SMOOTH	ARTIC WHITE
	5/4" X 4 1/2" COMPOSITE TRIM BOARD 1" ACTUAL)	JAMES HARDIE	SMOOTH	ARTIC WHITE
	5/4" X 5 1/2" COMPOSITE TRIM BOARD 1" ACTUAL)	JAMES HARDIE	SMOOTH	ARTIC WHITE
	5/4" X 9 1/4" COMPOSITE TRIM BOARD 1" ACTUAL)	JAMES HARDIE	SMOOTH PAD OUT 3/4" WHEN STACKED OVER LOWER BOARD TRIM	ARTIC WHITE
	5/4" X 11 1/4" COMPOSITE TRIM BOARD 1" ACTUAL)	JAMES HARDIE	SMOOTH	ARTIC WHITE
	5/4" COMPOSITE TRIM BOARD (1" ACTUAL)	JAMES HARDIE	SMOOTH	ARTIC WHITE
(;	4/4" X 3 1/2" COMPOSITE TRIM BOARD 3/4" ACTUAL)	JAMES HARDIE	SMOOTH	ARTIC WHITE
	4/4" X 5 1/2" COMPOSITE TRIM BOARD 3/4" ACTUAL)	JAMES HARDIE	SMOOTH	ARTIC WHITE
	4/4" X 7 1/4" COMPOSITE TRIM BOARD 3/4" ACTUAL)	JAMES HARDIE	SMOOTH	ARTIC WHITE
	4/4" COMPOSITE TRIM BOARD (3/4" ACTUAL)	JAMES HARDIE	SMOOTH	ARTIC WHITE
6 F	PREFINISHED SHEET MTL GUTTER	-	6"W X 4 1/2"D (U.N.O.)	WHITE
	PREFINISHED SHEET MTL DOWN SPOUT	-	4"W X 3"D (U.N.O.)	WHITE
	PREFINISHED SHEET MTL "Z" FLASHING	-	-	WHITE
V	PREFINISHED SHEET MTL FLASHING N/4" VERT. LEG OVER ICE & WATER SHIELD	-	-	-
	PRECAST WATERTABLE/SILL PREFINISHED SHEET MTL FLASHING	-	-	-
12 F	HOSE BIBB	-	-	-
13 L	IGHT FIXTURE	-	-	-
14 A	ASPHALT ARCHITECTURAL SHINGLES	-	-	-
	CONCRETE FOOTING, SEE STRUCT	-	-	-
16 V	WALL LOUVER - SEE DETAIL 7/A8.01	-	-	-
18 F	RIDGE VENT	-	-	-
19 S		-	SEE SHEET A8.6 FOR WINDOW TYPES	-
-	PREFINISHED SHEET MTL DRIP EDGE IRIM			
21 C	ORNAMENTAL PVC BRACKET		SUBMIT STYLES	
F F C S	AT INTERSECTION OF VALLEYS, PROVIDE SHEET MTL FLASHING AT ROOF 36" ON ALL SLOPED SURFACES OVER ICE & WATER SHIELD. WRAP SHEET MTL OVER FASCIA BOARDS AND INTO GUTTER.			
	COMPOSITE INSIDE TRIM BOARD (3/4" ACTUAL)	JAMES HARDIE	SMOOTH	ARTIC WHITE
24 🤆	GROUND MOUNTED UP-LIGHT	-	-	-


DRIP FASCIA FLASHING ADDED IN FRONT OF COMPOSITE TRIM BOARDS FOR DETAIL



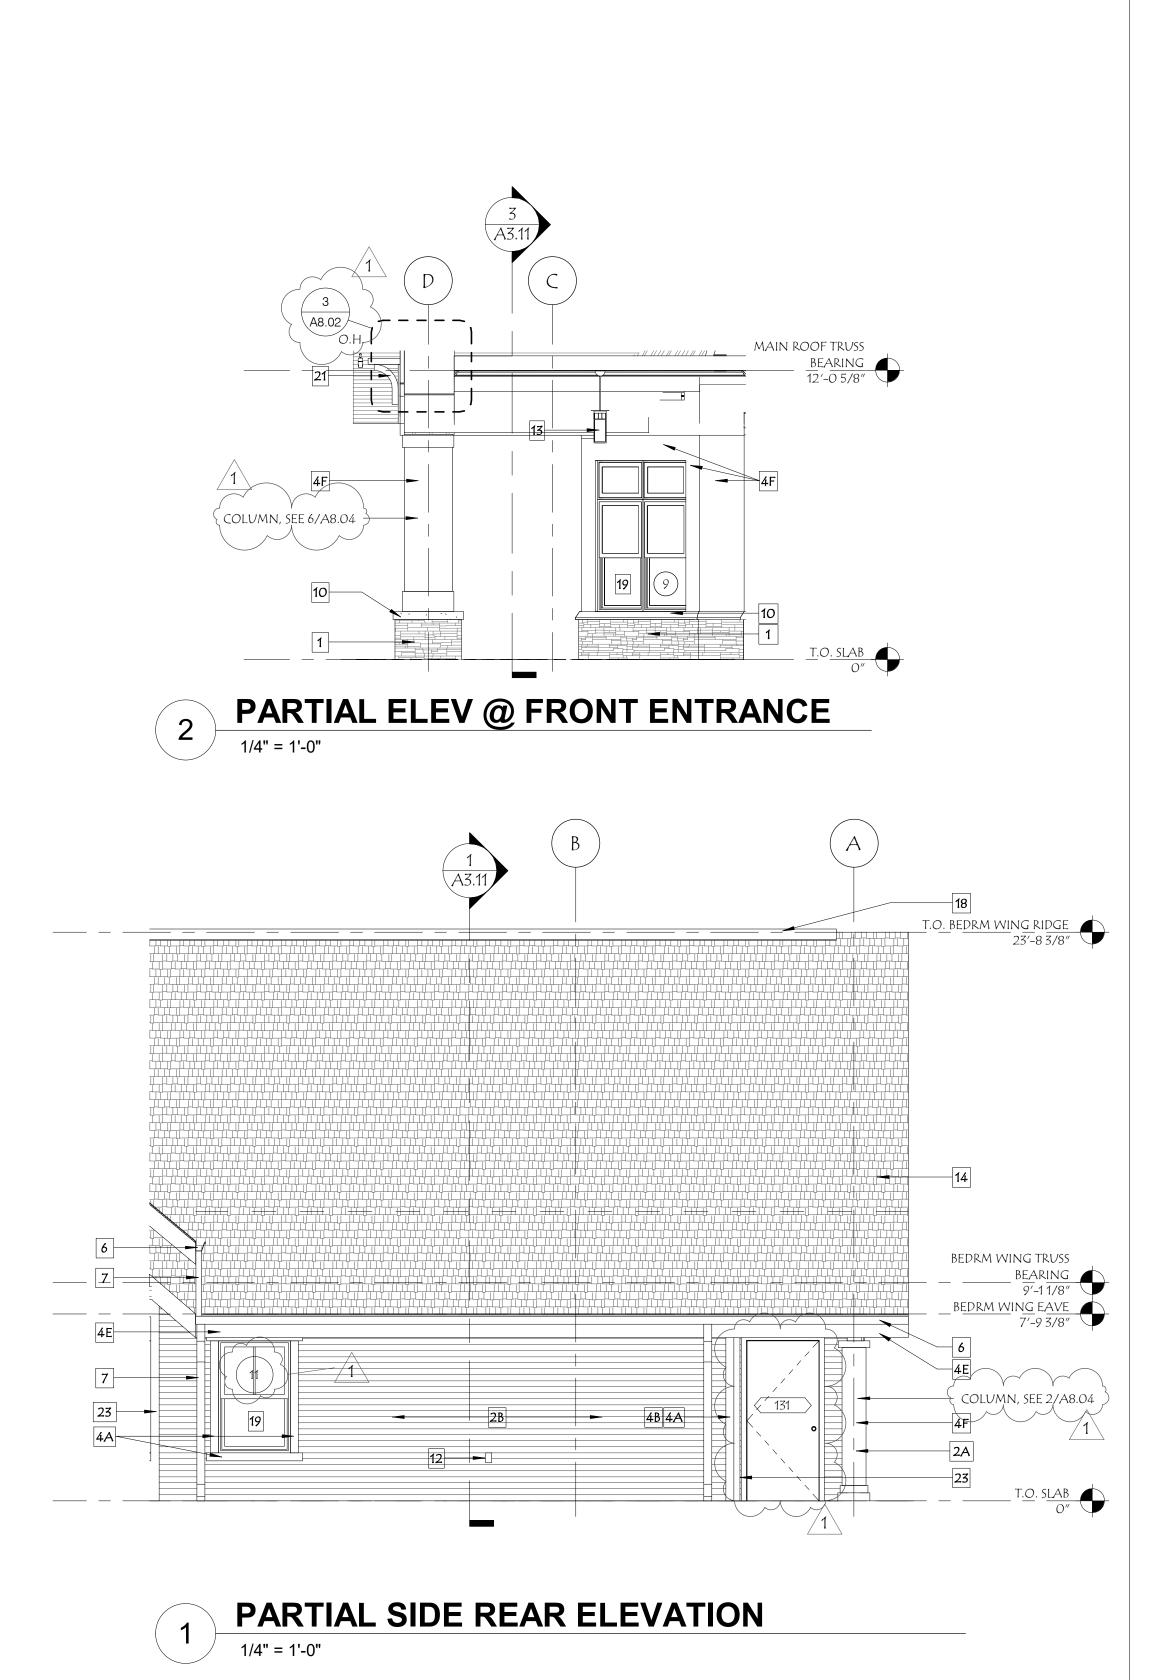





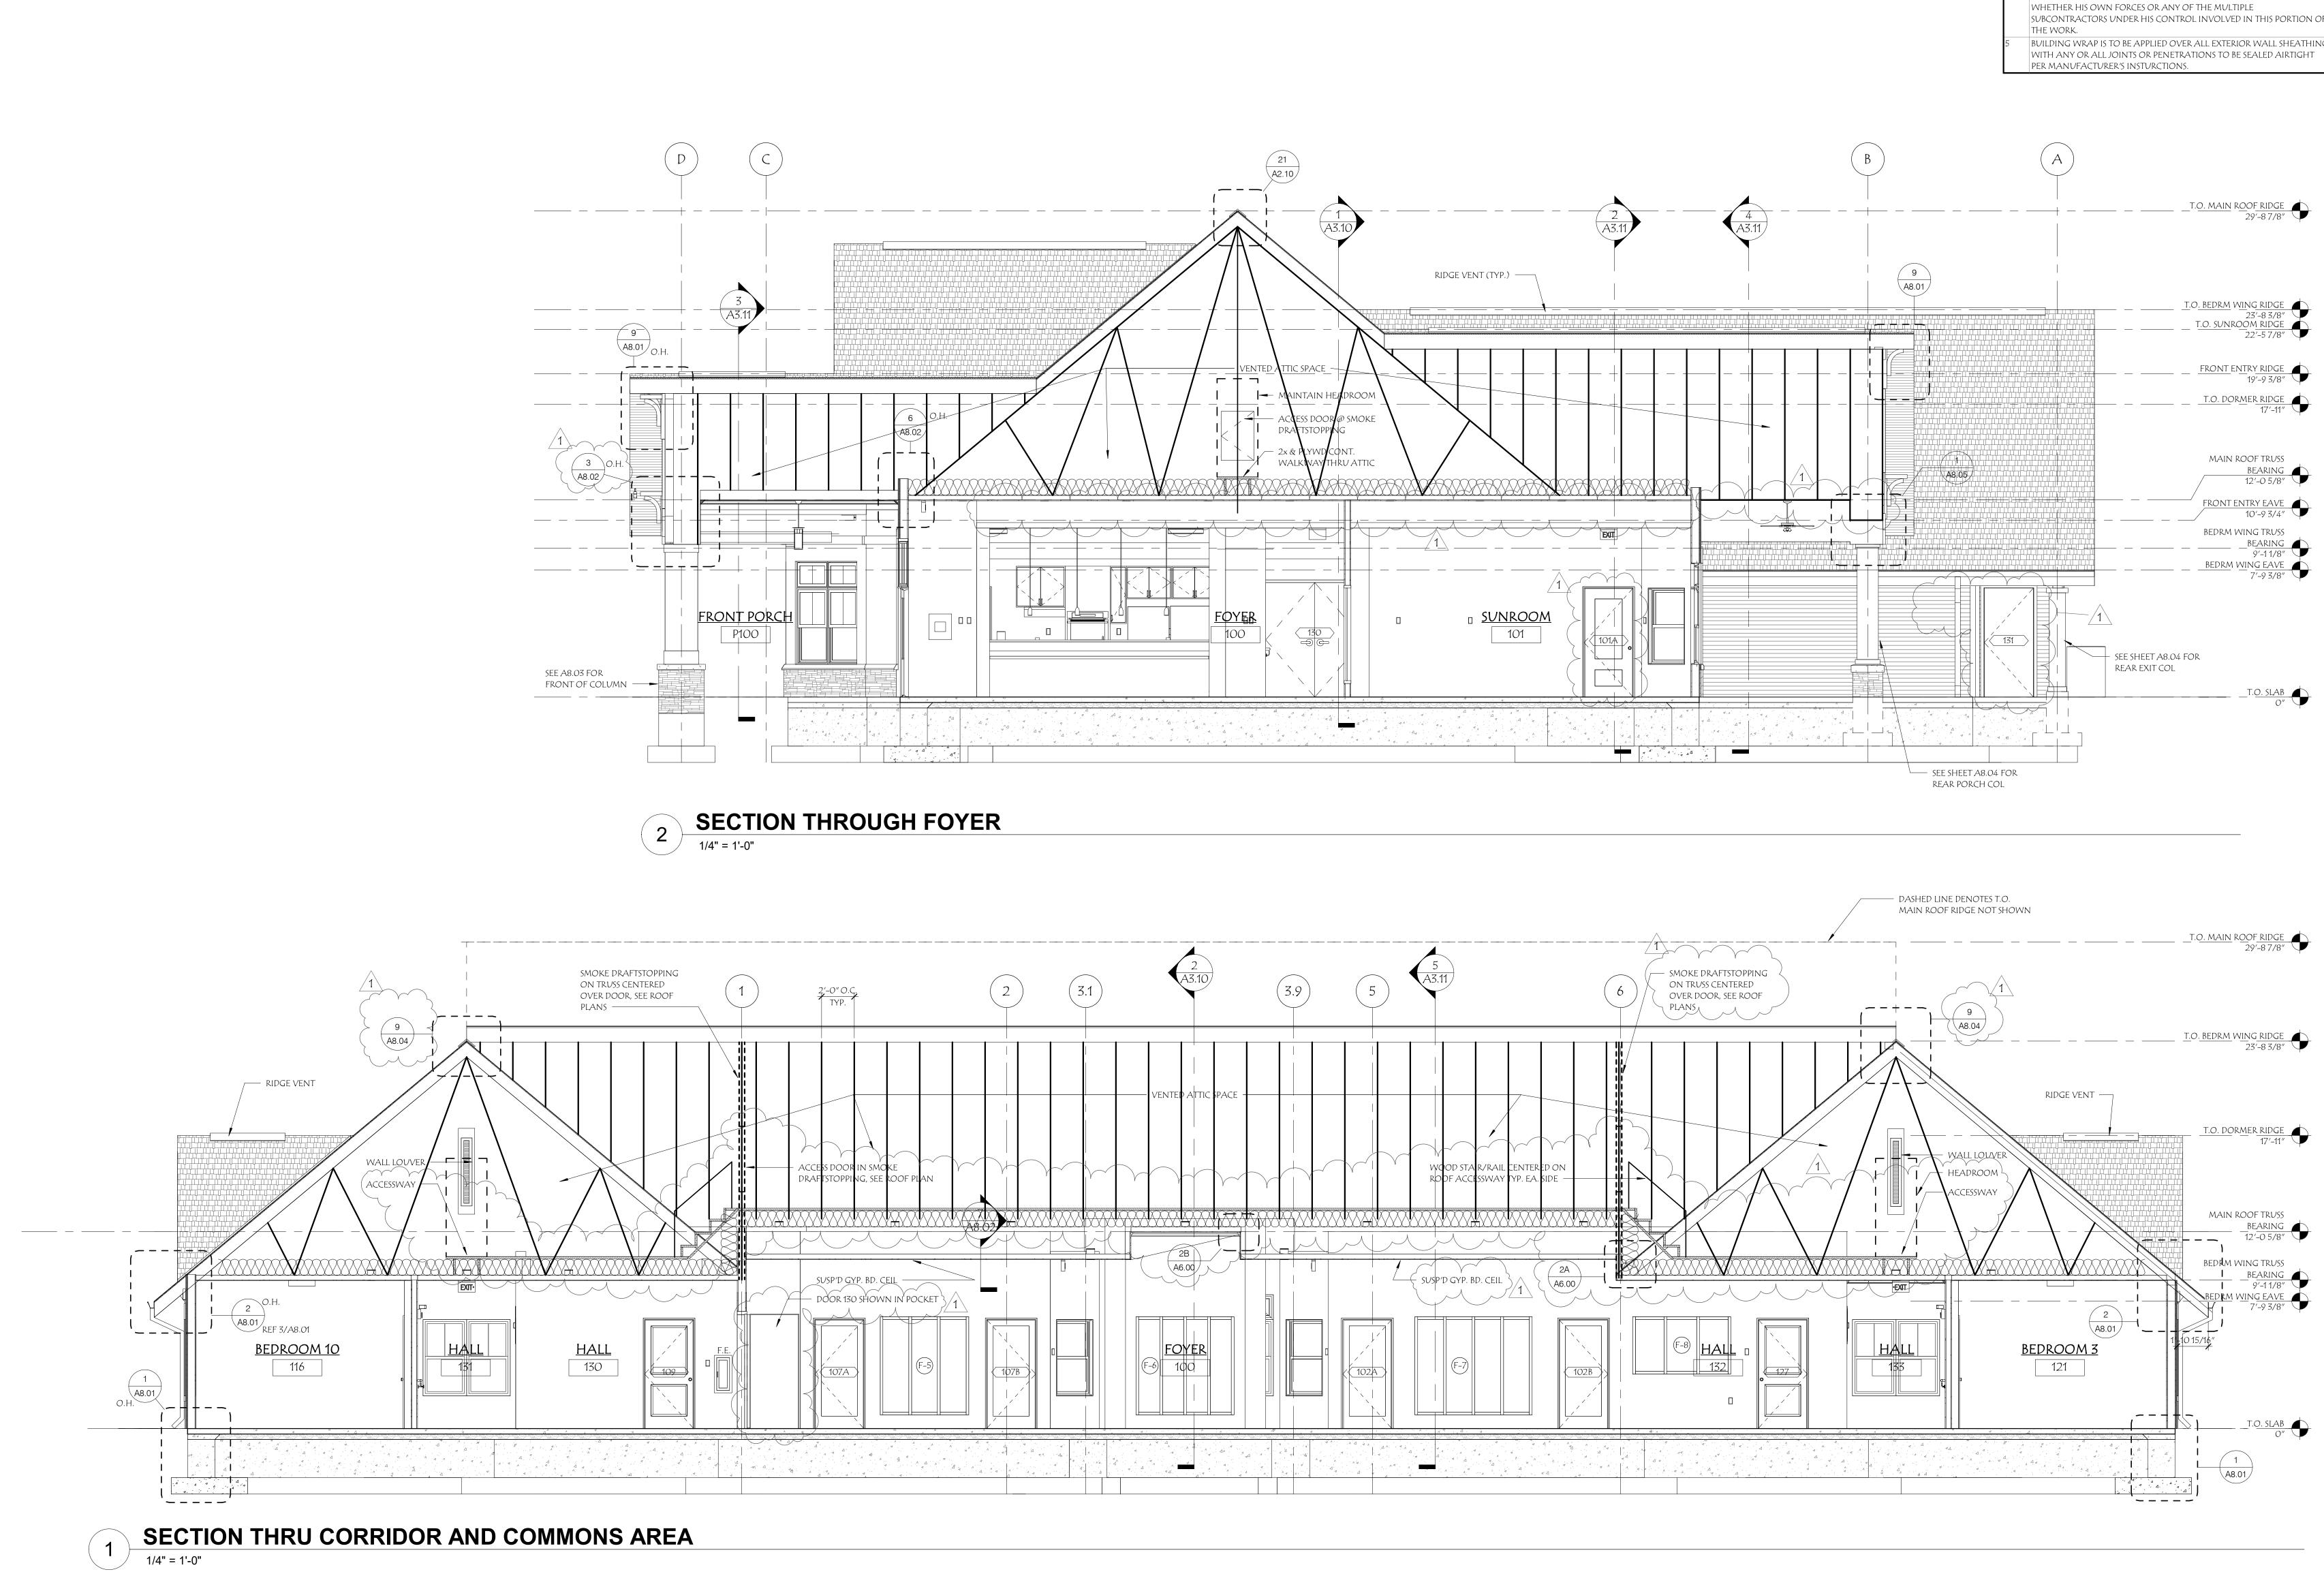

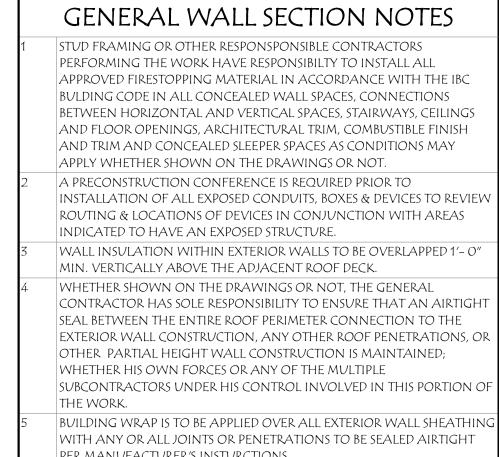




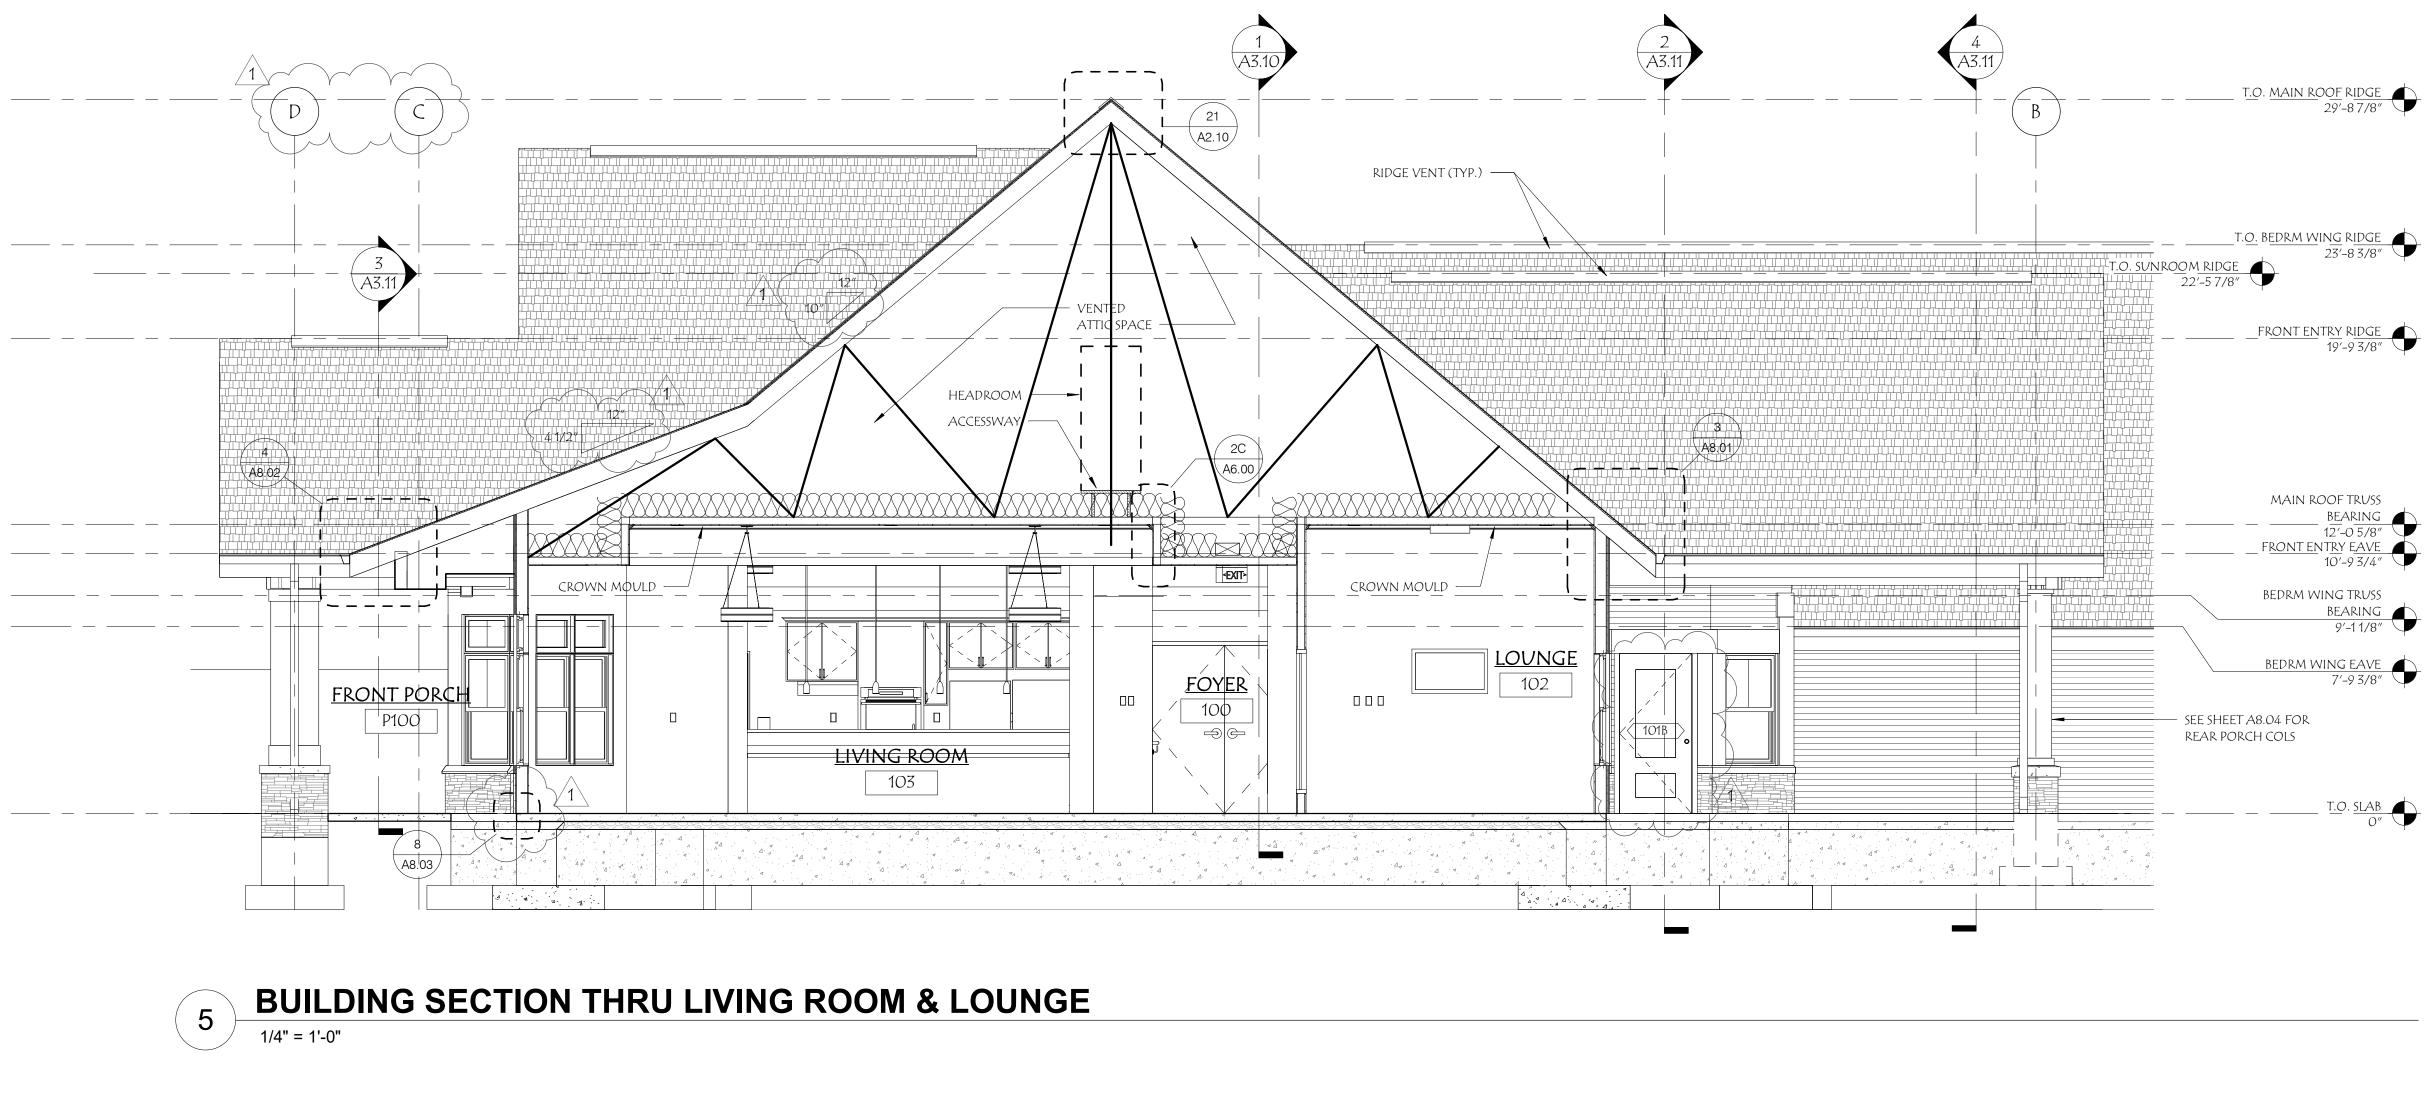

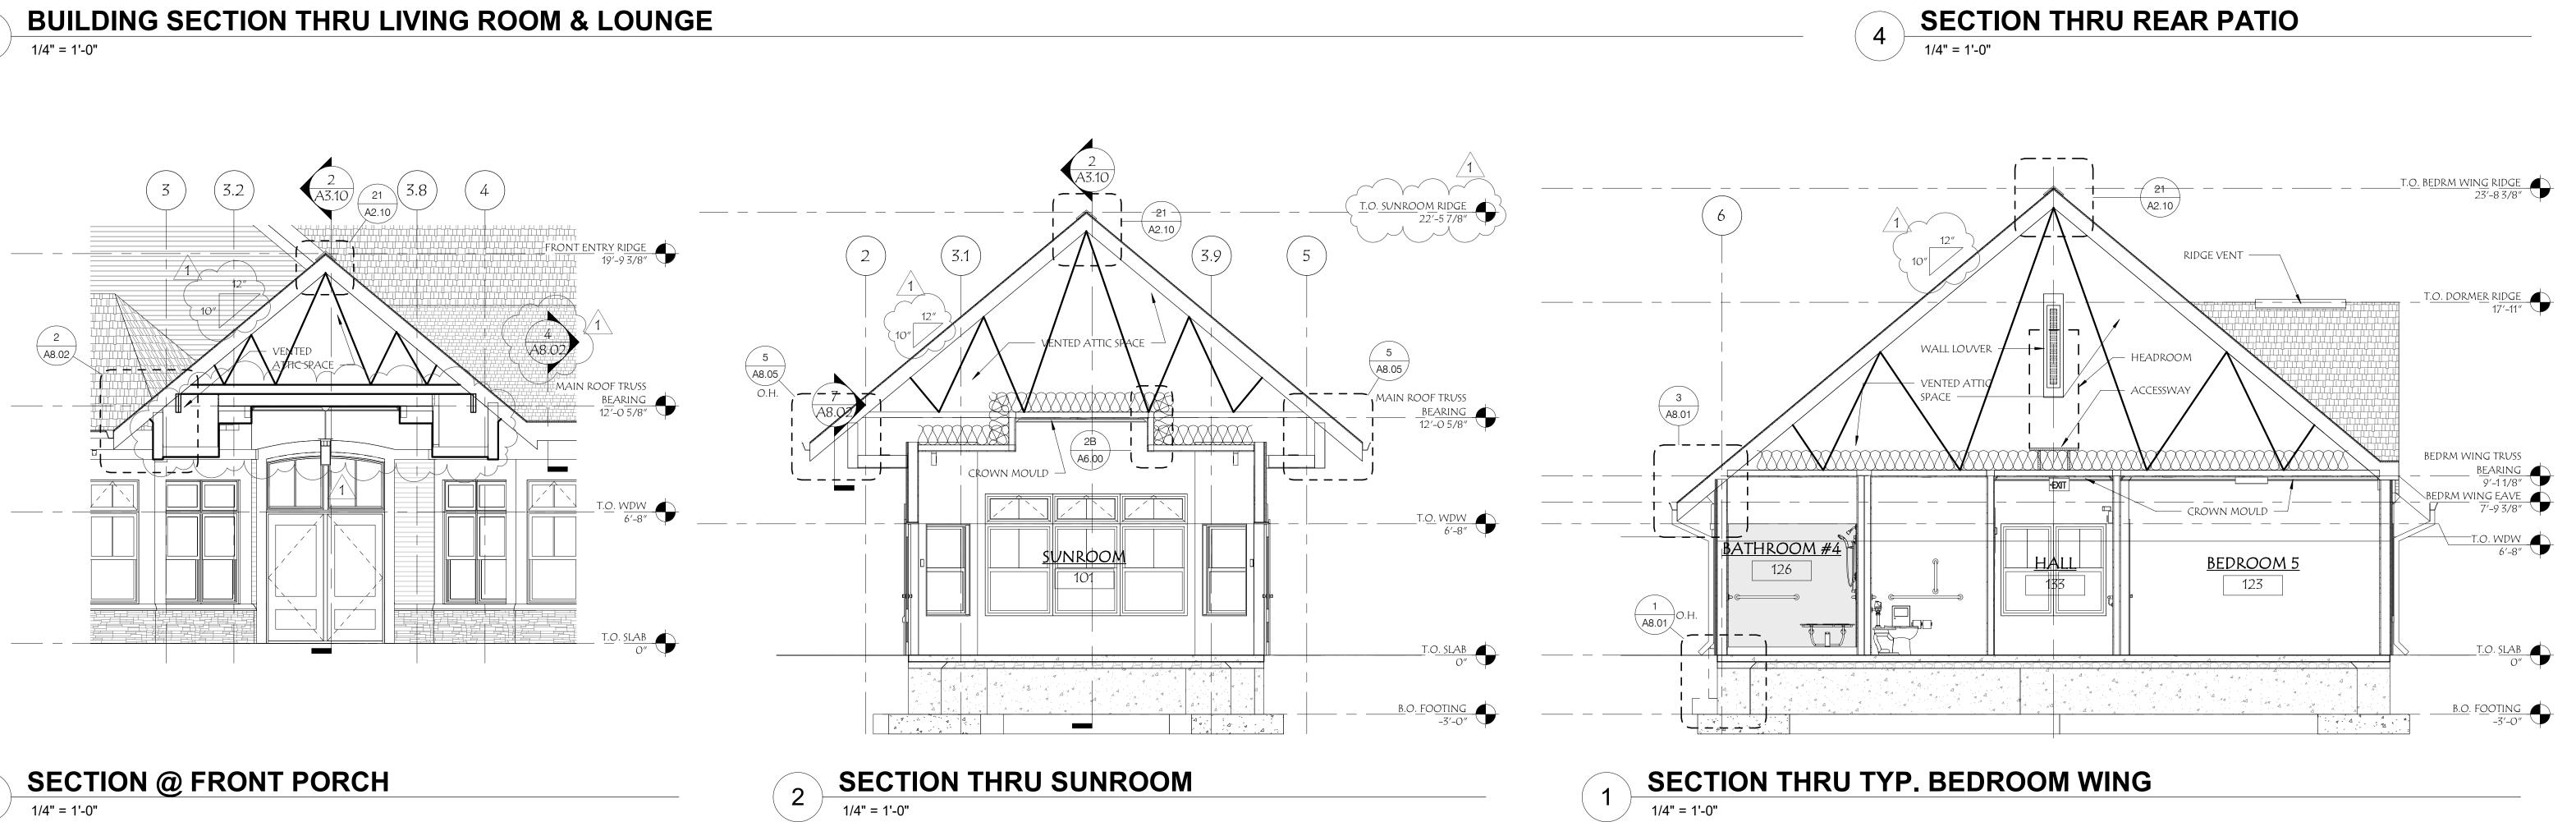




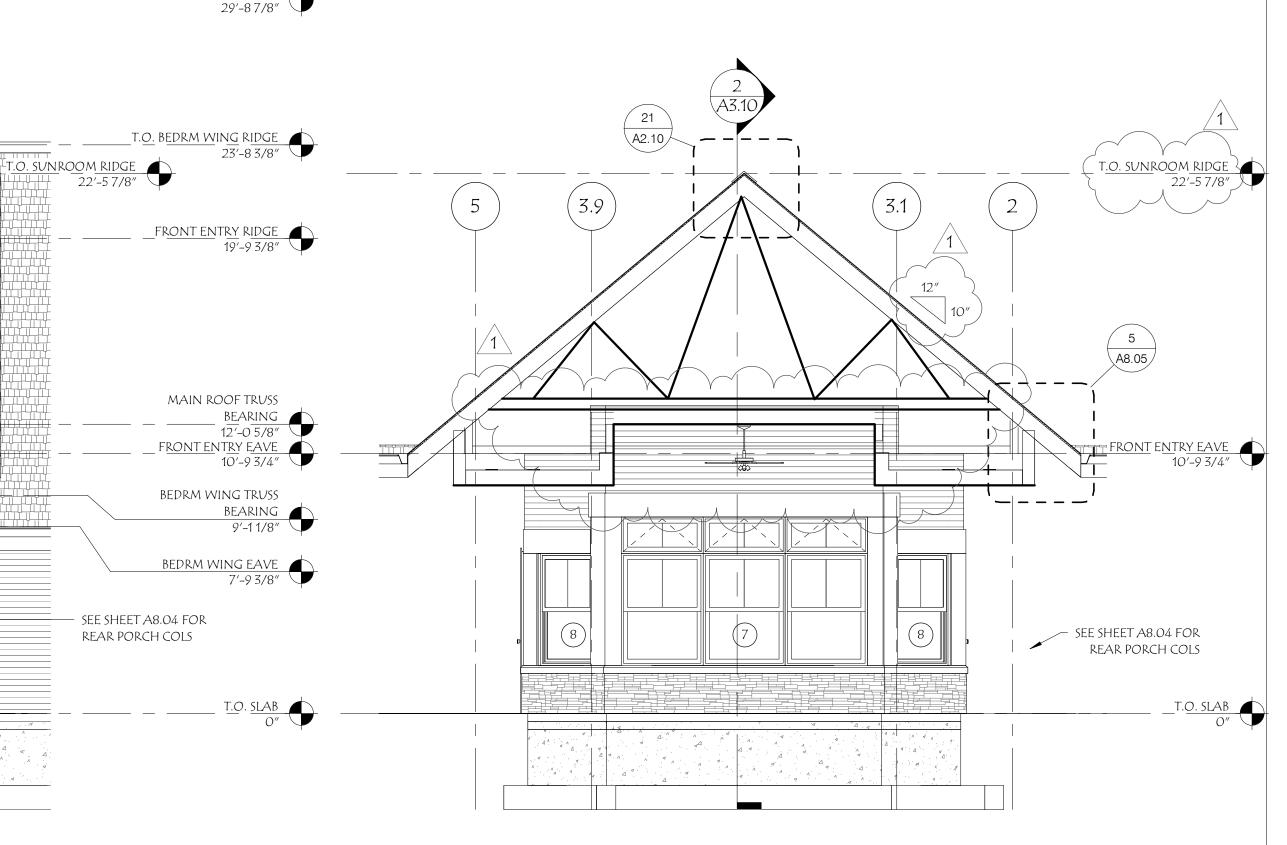

GENERAL WALL SECTION NOTES STUD FRAMING OR OTHER RESPONSPONSIBLE CONTRACTORS PERFORMING THE WORK HAVE RESPONSIBILTY TO INSTALL ALL APPROVED FIRESTOPPING MATERIAL IN ACCORDANCE WITH THE IBC BULDING CODE IN ALL CONCEALED WALL SPACES, CONNECTIONS BETWEEN HORIZONTAL AND VERTICAL SPACES, STAIRWAYS, CEILINGS AND FLOOR OPENINGS, ARCHITECTURAL TRIM, COMBUSTIBLE FINISH AND TRIM AND CONCEALED SLEEPER SPACES AS CONDITIONS MAY APPLY WHETHER SHOWN ON THE DRAWINGS OR NOT. A PRECONSTRUCTION CONFERENCE IS REQUIRED PRIOR TO INSTALLATION OF ALL EXPOSED CONDUITS, BOXES & DEVICES TO REVIEW ROUTING & LOCATIONS OF DEVICES IN CONJUNCTION WITH AREAS INDICATED TO HAVE AN EXPOSED STRUCTURE. WALL INSULATION WITHIN EXTERIOR WALLS TO BE OVERLAPPED 1'- O" MIN. VERTICALLY ABOVE THE ADJACENT ROOF DECK. WHETHER SHOWN ON THE DRAWINGS OR NOT, THE GENERAL CONTRACTOR HAS SOLE RESPONSIBILITY TO ENSURE THAT AN AIRTIGHT SEAL BETWEEN THE ENTIRE ROOF PERIMETER CONNECTION TO THE EXTERIOR WALL CONSTRUCTION, ANY OTHER ROOF PENETRATIONS, OR OTHER PARTIAL HEIGHT WALL CONSTRUCTION IS MAINTAINED; WHETHER HIS OWN FORCES OR ANY OF THE MULTIPLE SUBCONTRACTORS UNDER HIS CONTROL INVOLVED IN THIS PORTION OF THE WORK. BUILDING WRAP IS TO BE APPLIED OVER ALL EXTERIOR WALL SHEATHING WITH ANY OR ALL JOINTS OR PENETRATIONS TO BE SEALED AIRTIGHT

PER MANUFACTURER'S INSTURCTIONS.



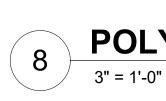

9

— METAL "SCHLUTER" BASE

SEE 8/A4.00 FOR BALANCE OF NOTES

- 'GREEN BOARD' DRYWALL

PRIOR TO INSTALLATION)

- INSTALL WALL PANELS BEFORE POLYMER SYSTEM TO

ALLOW POLYMER BASE TO BOND TO BOT OF SOLID

SURFACE PANEL CREATING WATER-TIGHT" BOND

POURED POLYMER FLOOR SYSTEM W/ MEDIUM TEXTU

(TEXTURE TO BE APPROVED FROM SUBMITTED SAMPLES

SLOPE TO DRAIN

1/4"/FT (MIN)

4" TALL POLYMER BASE W/ INTEGRAL COVE

CONC. CONT'R TO RECESS SLAB 3/4" @ SHOWERS &

TYP. POLYMER BASE


TOILETS -----




slope —


1 1 5 5 5 1 1



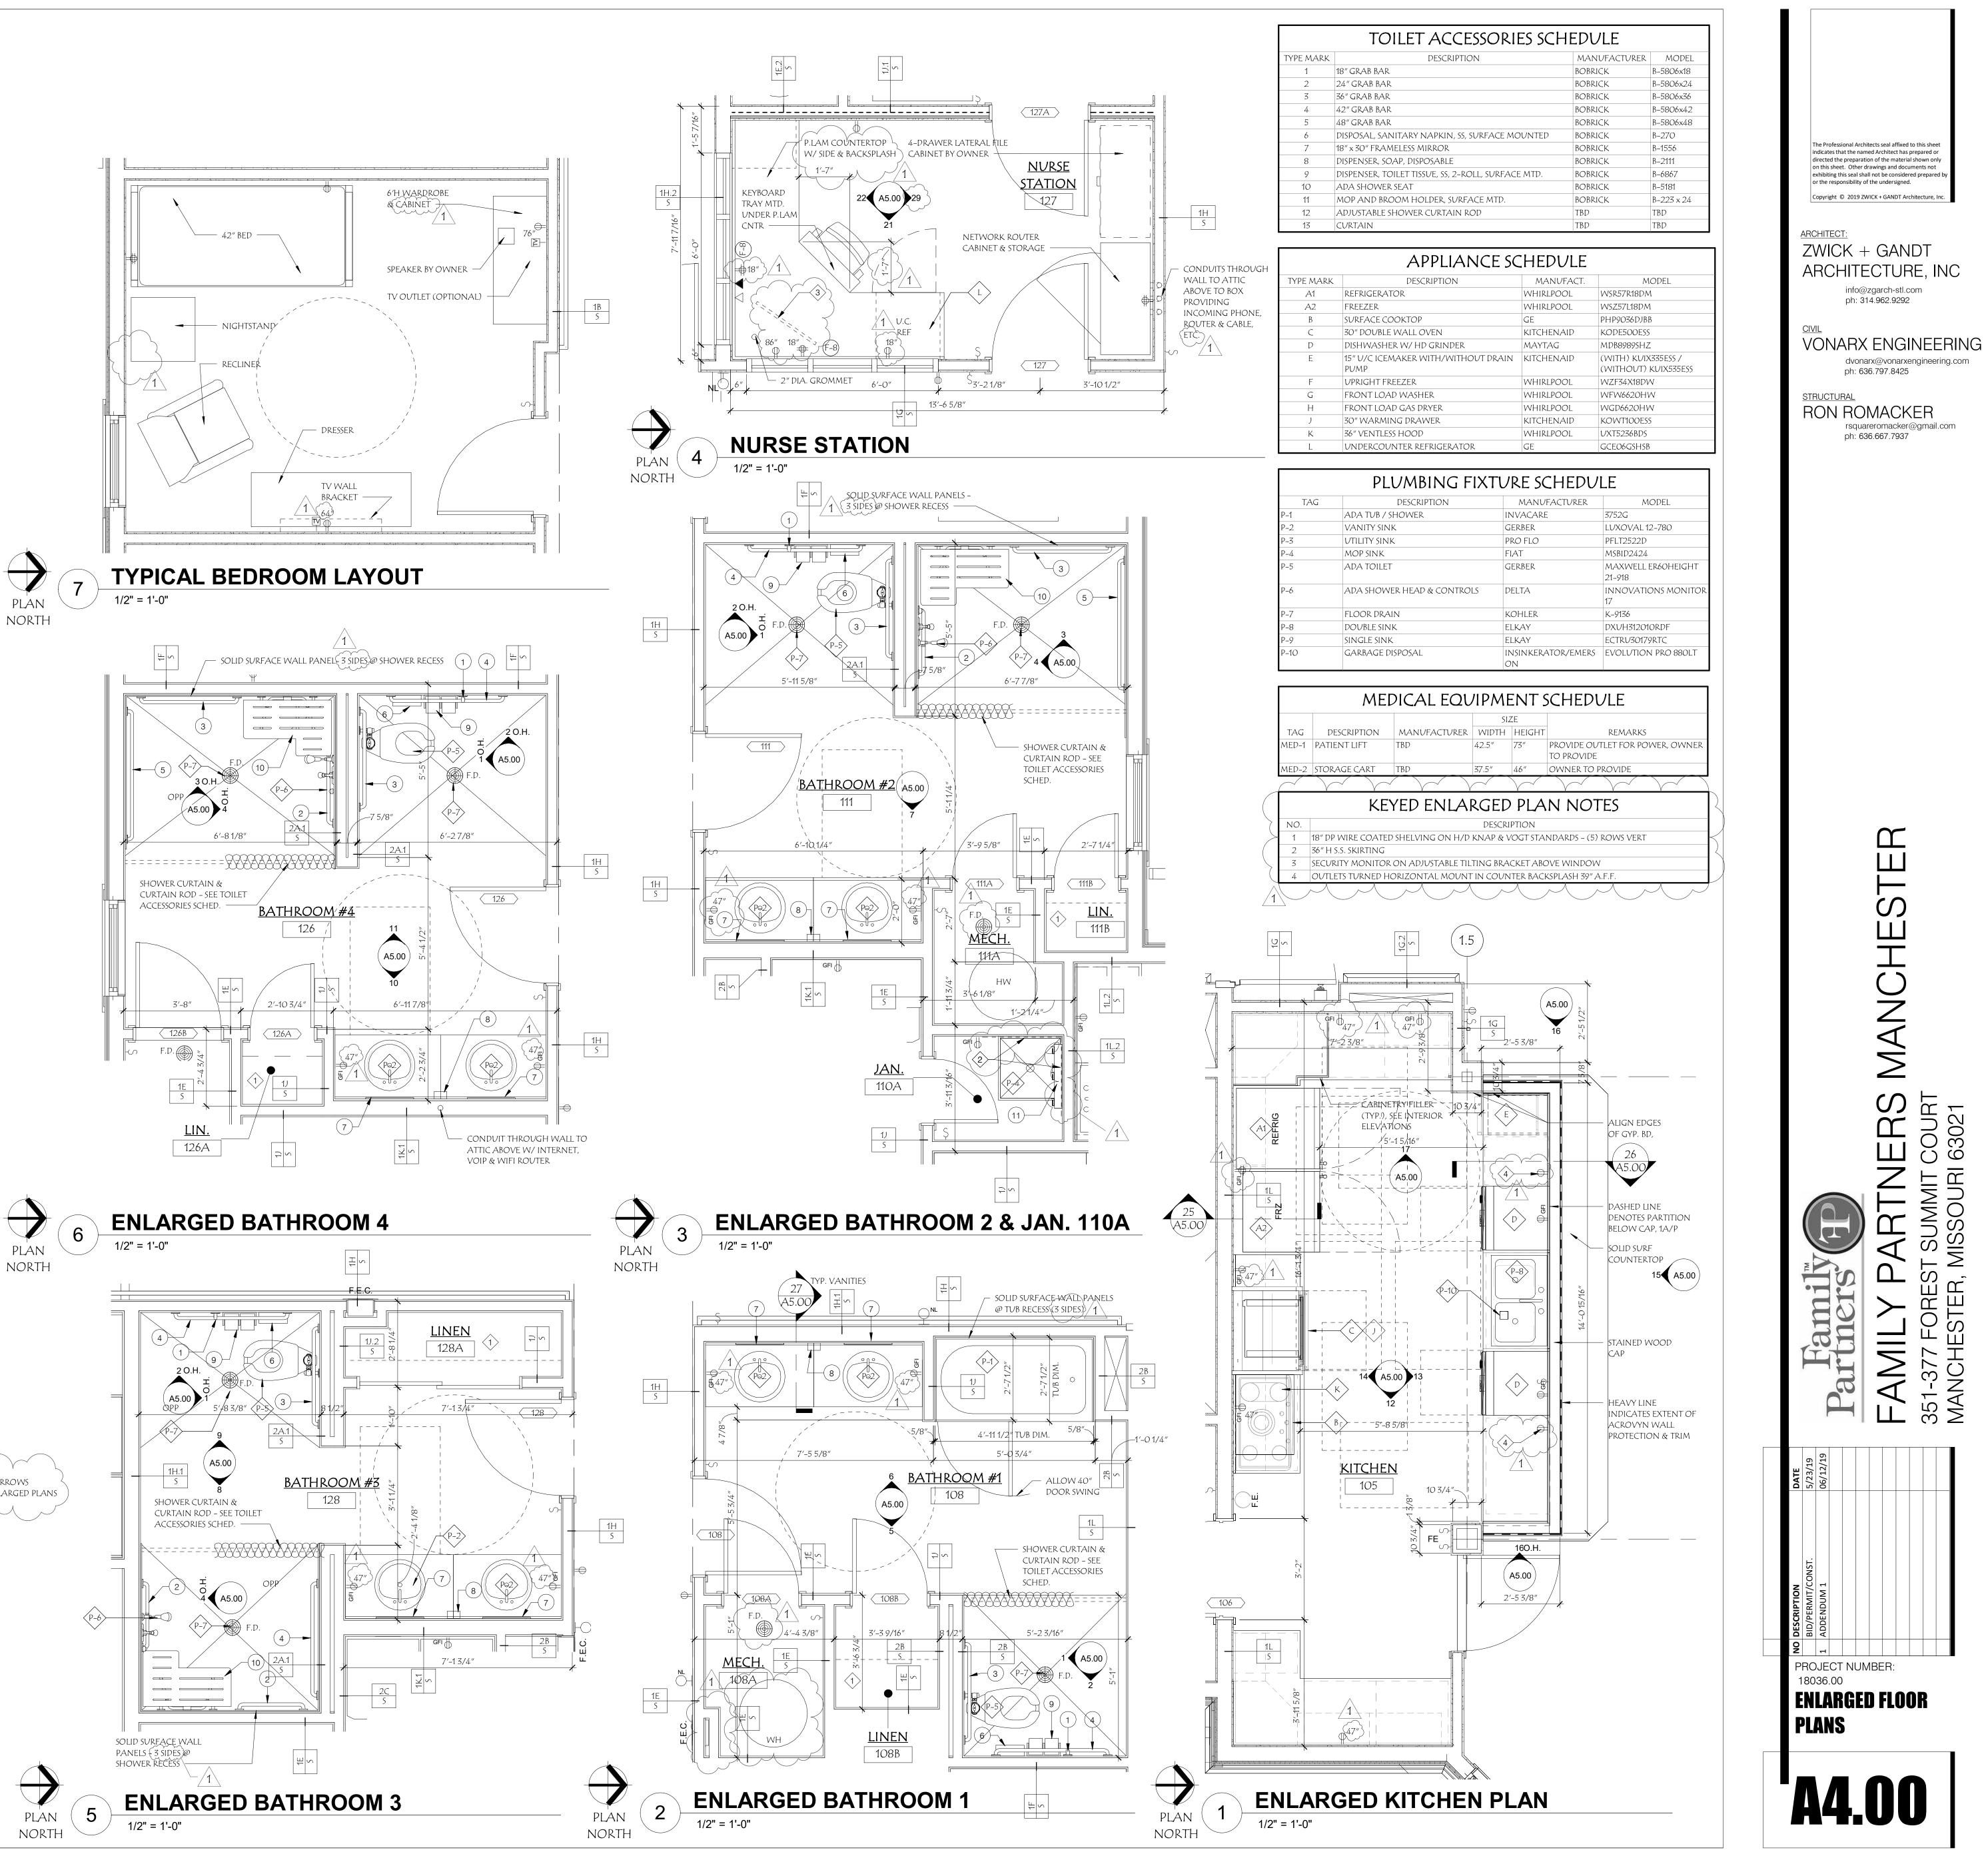

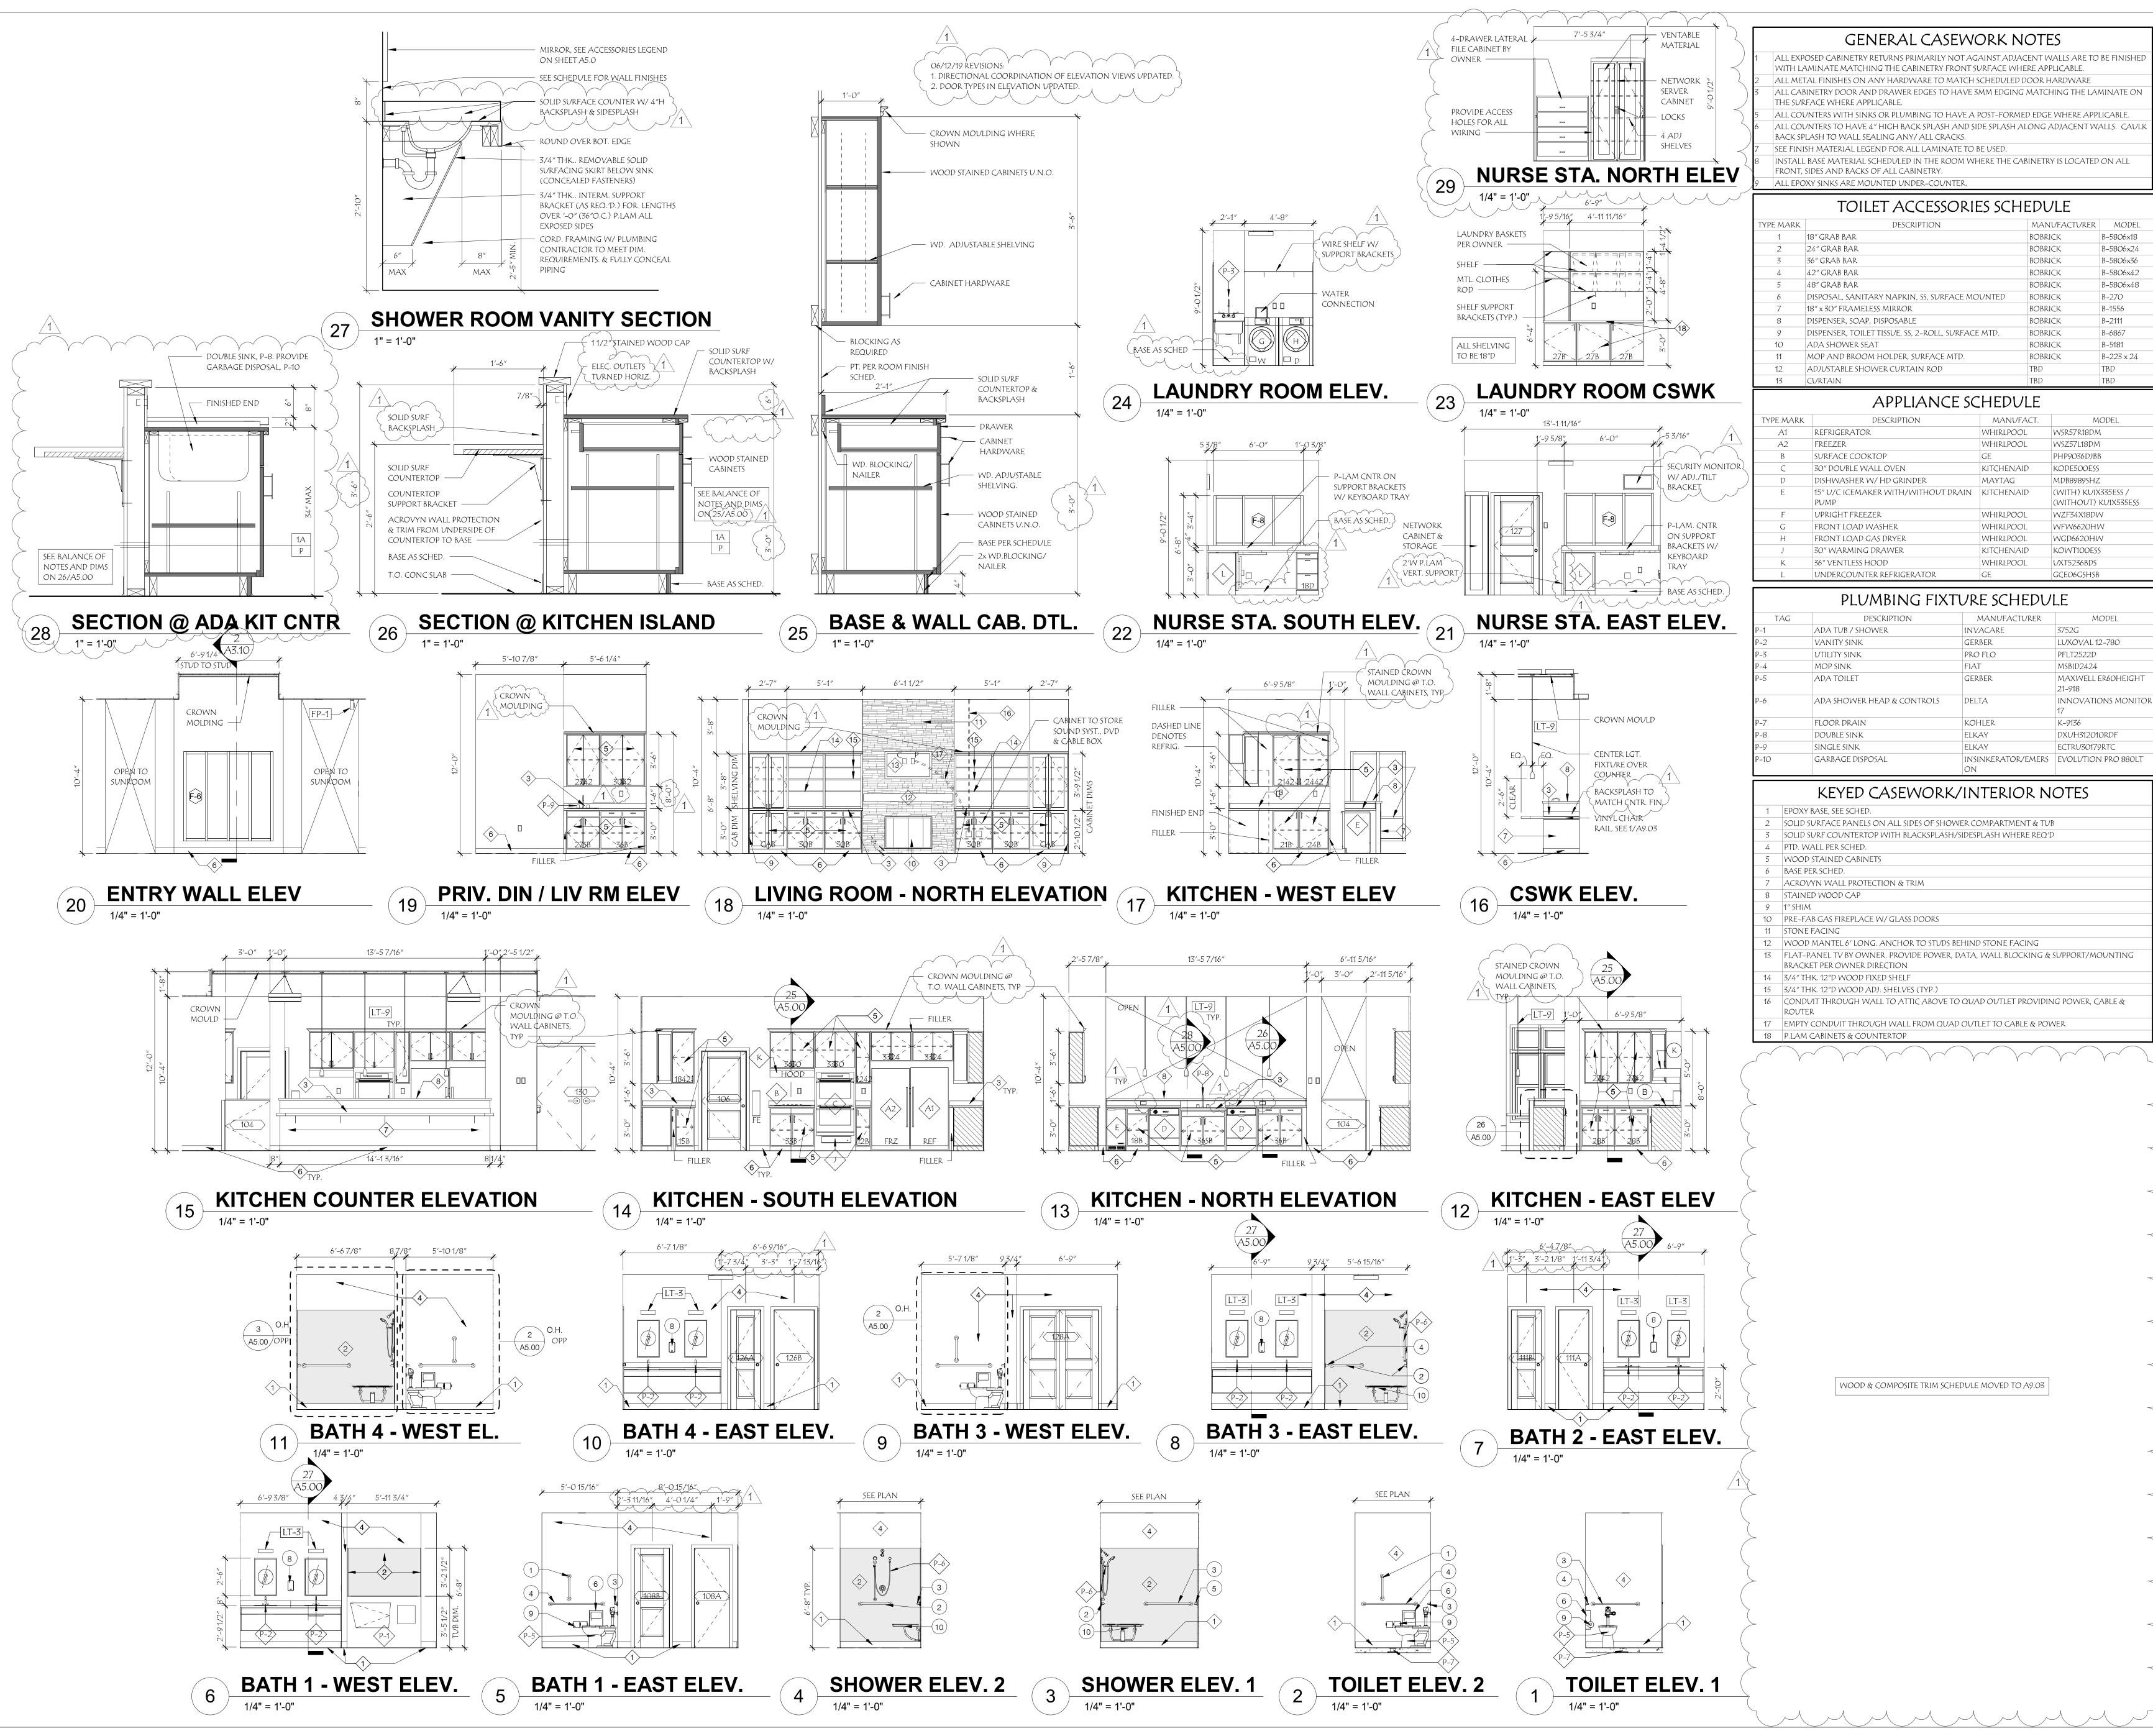




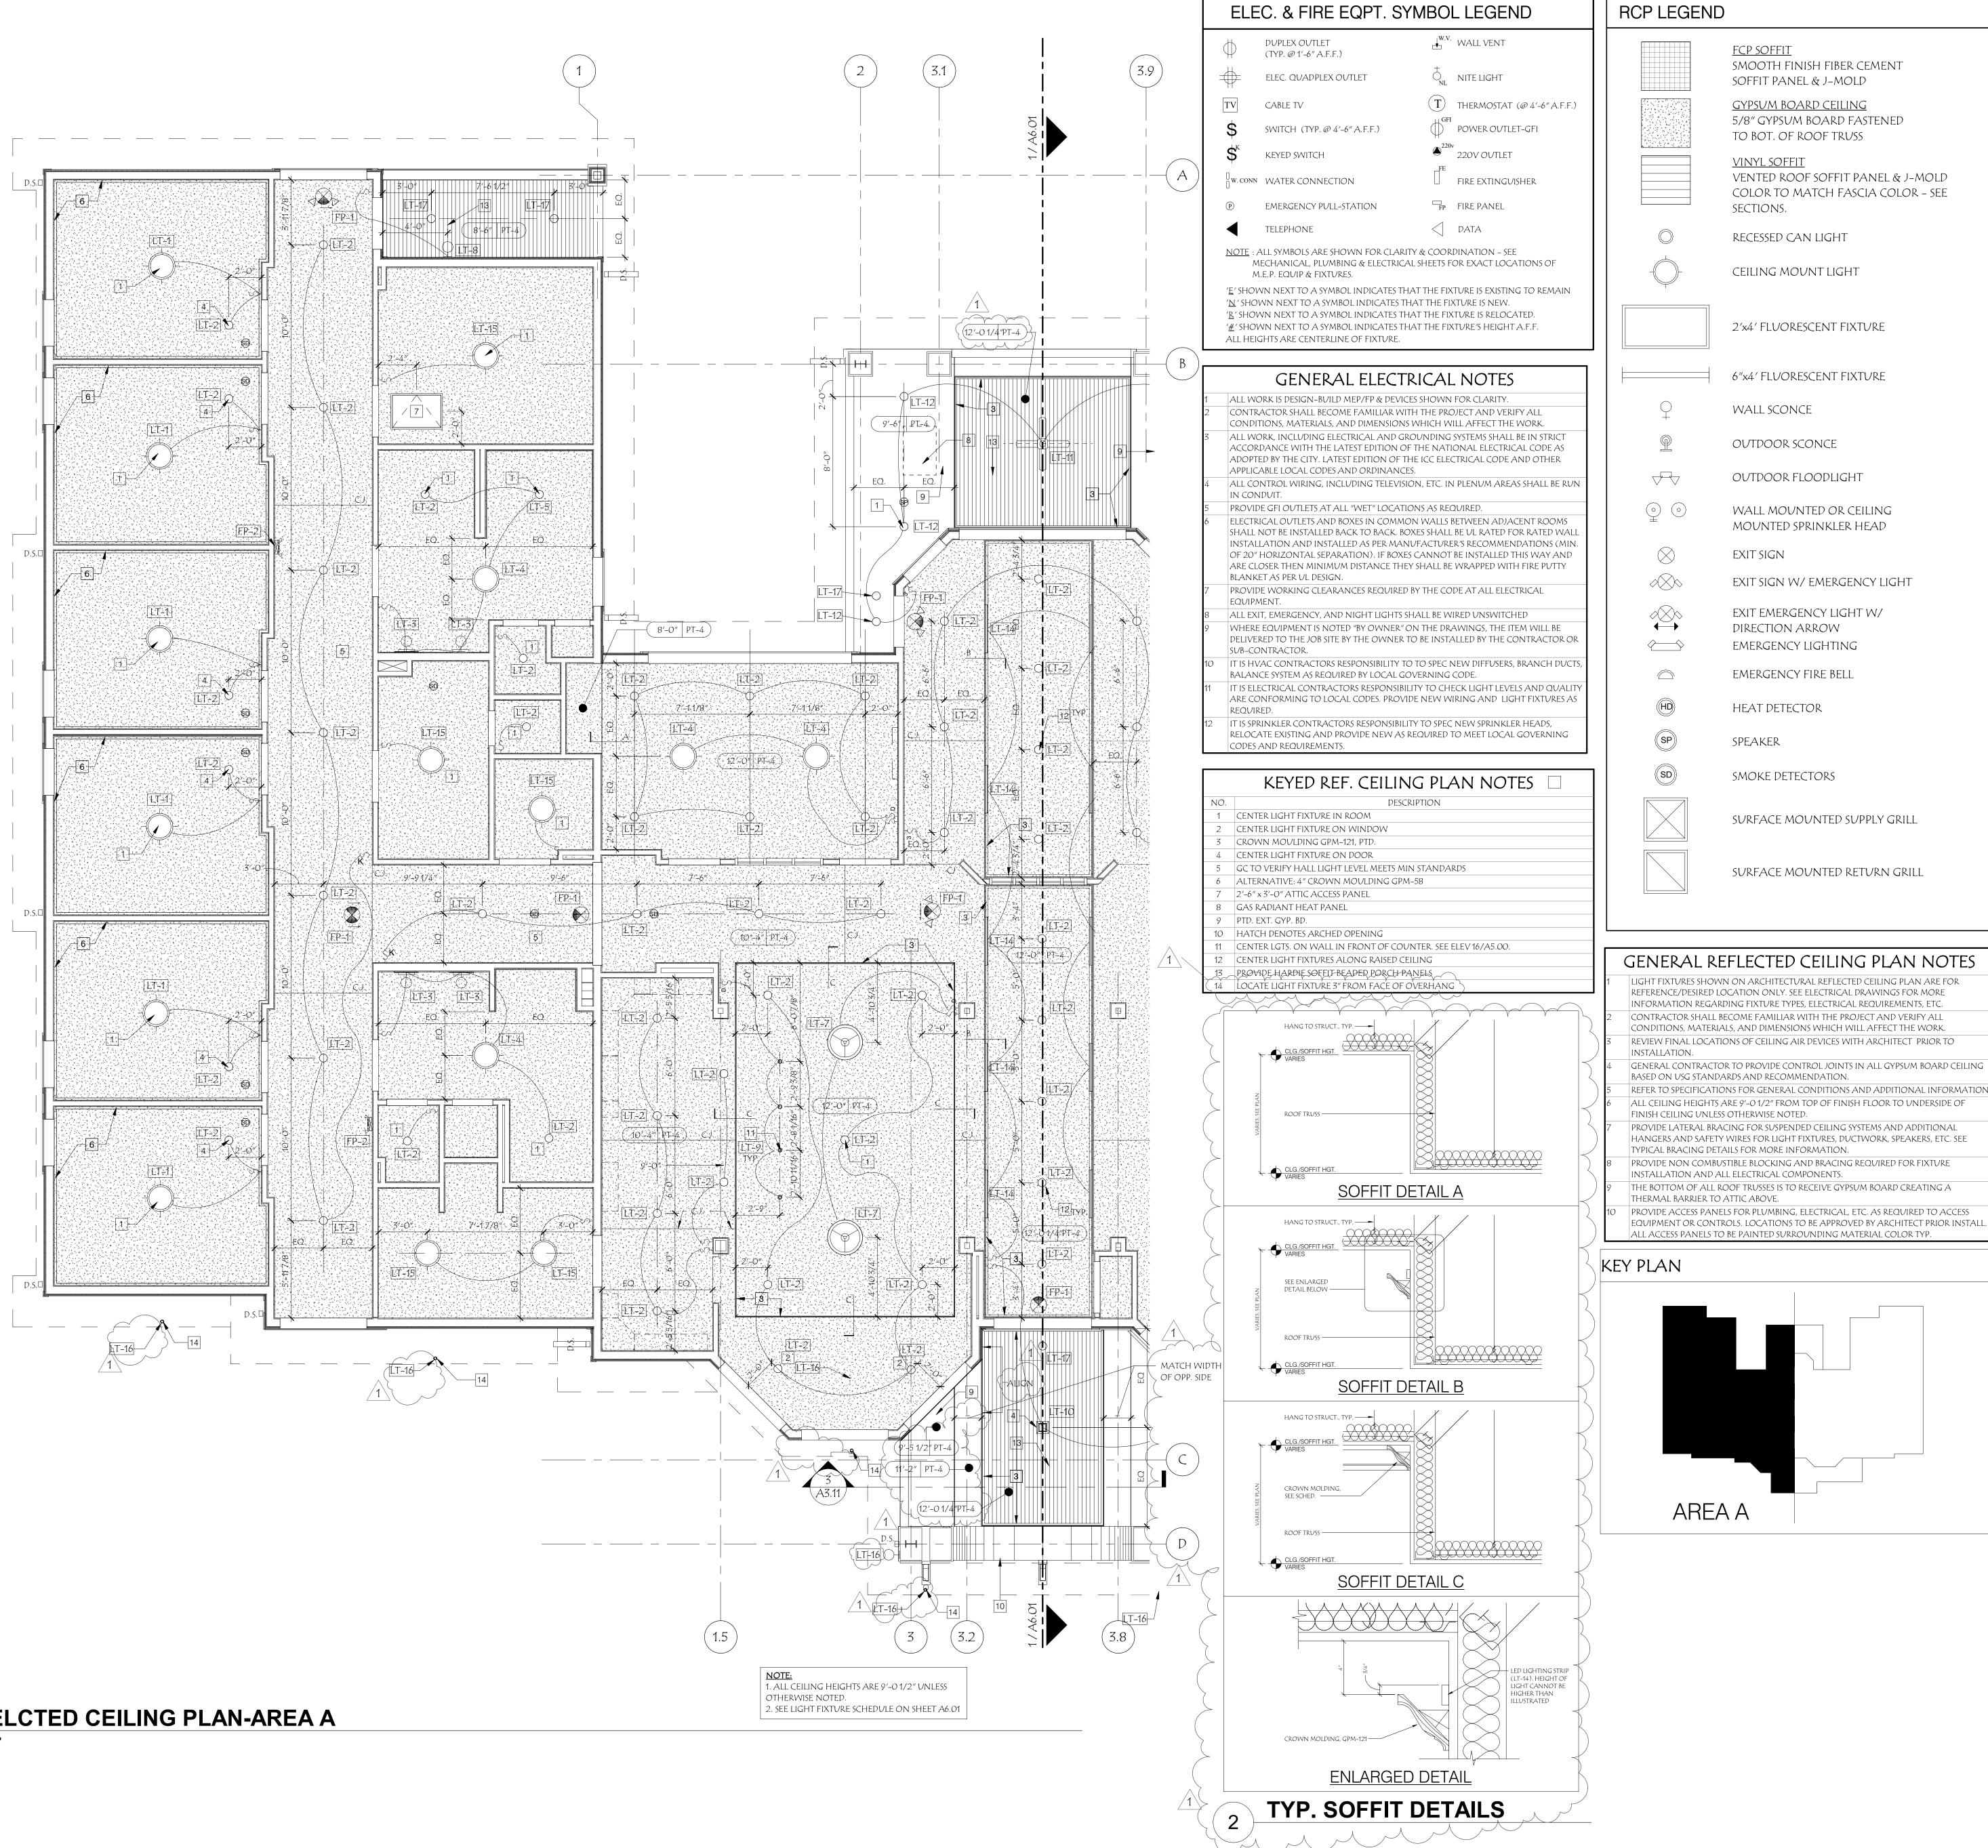







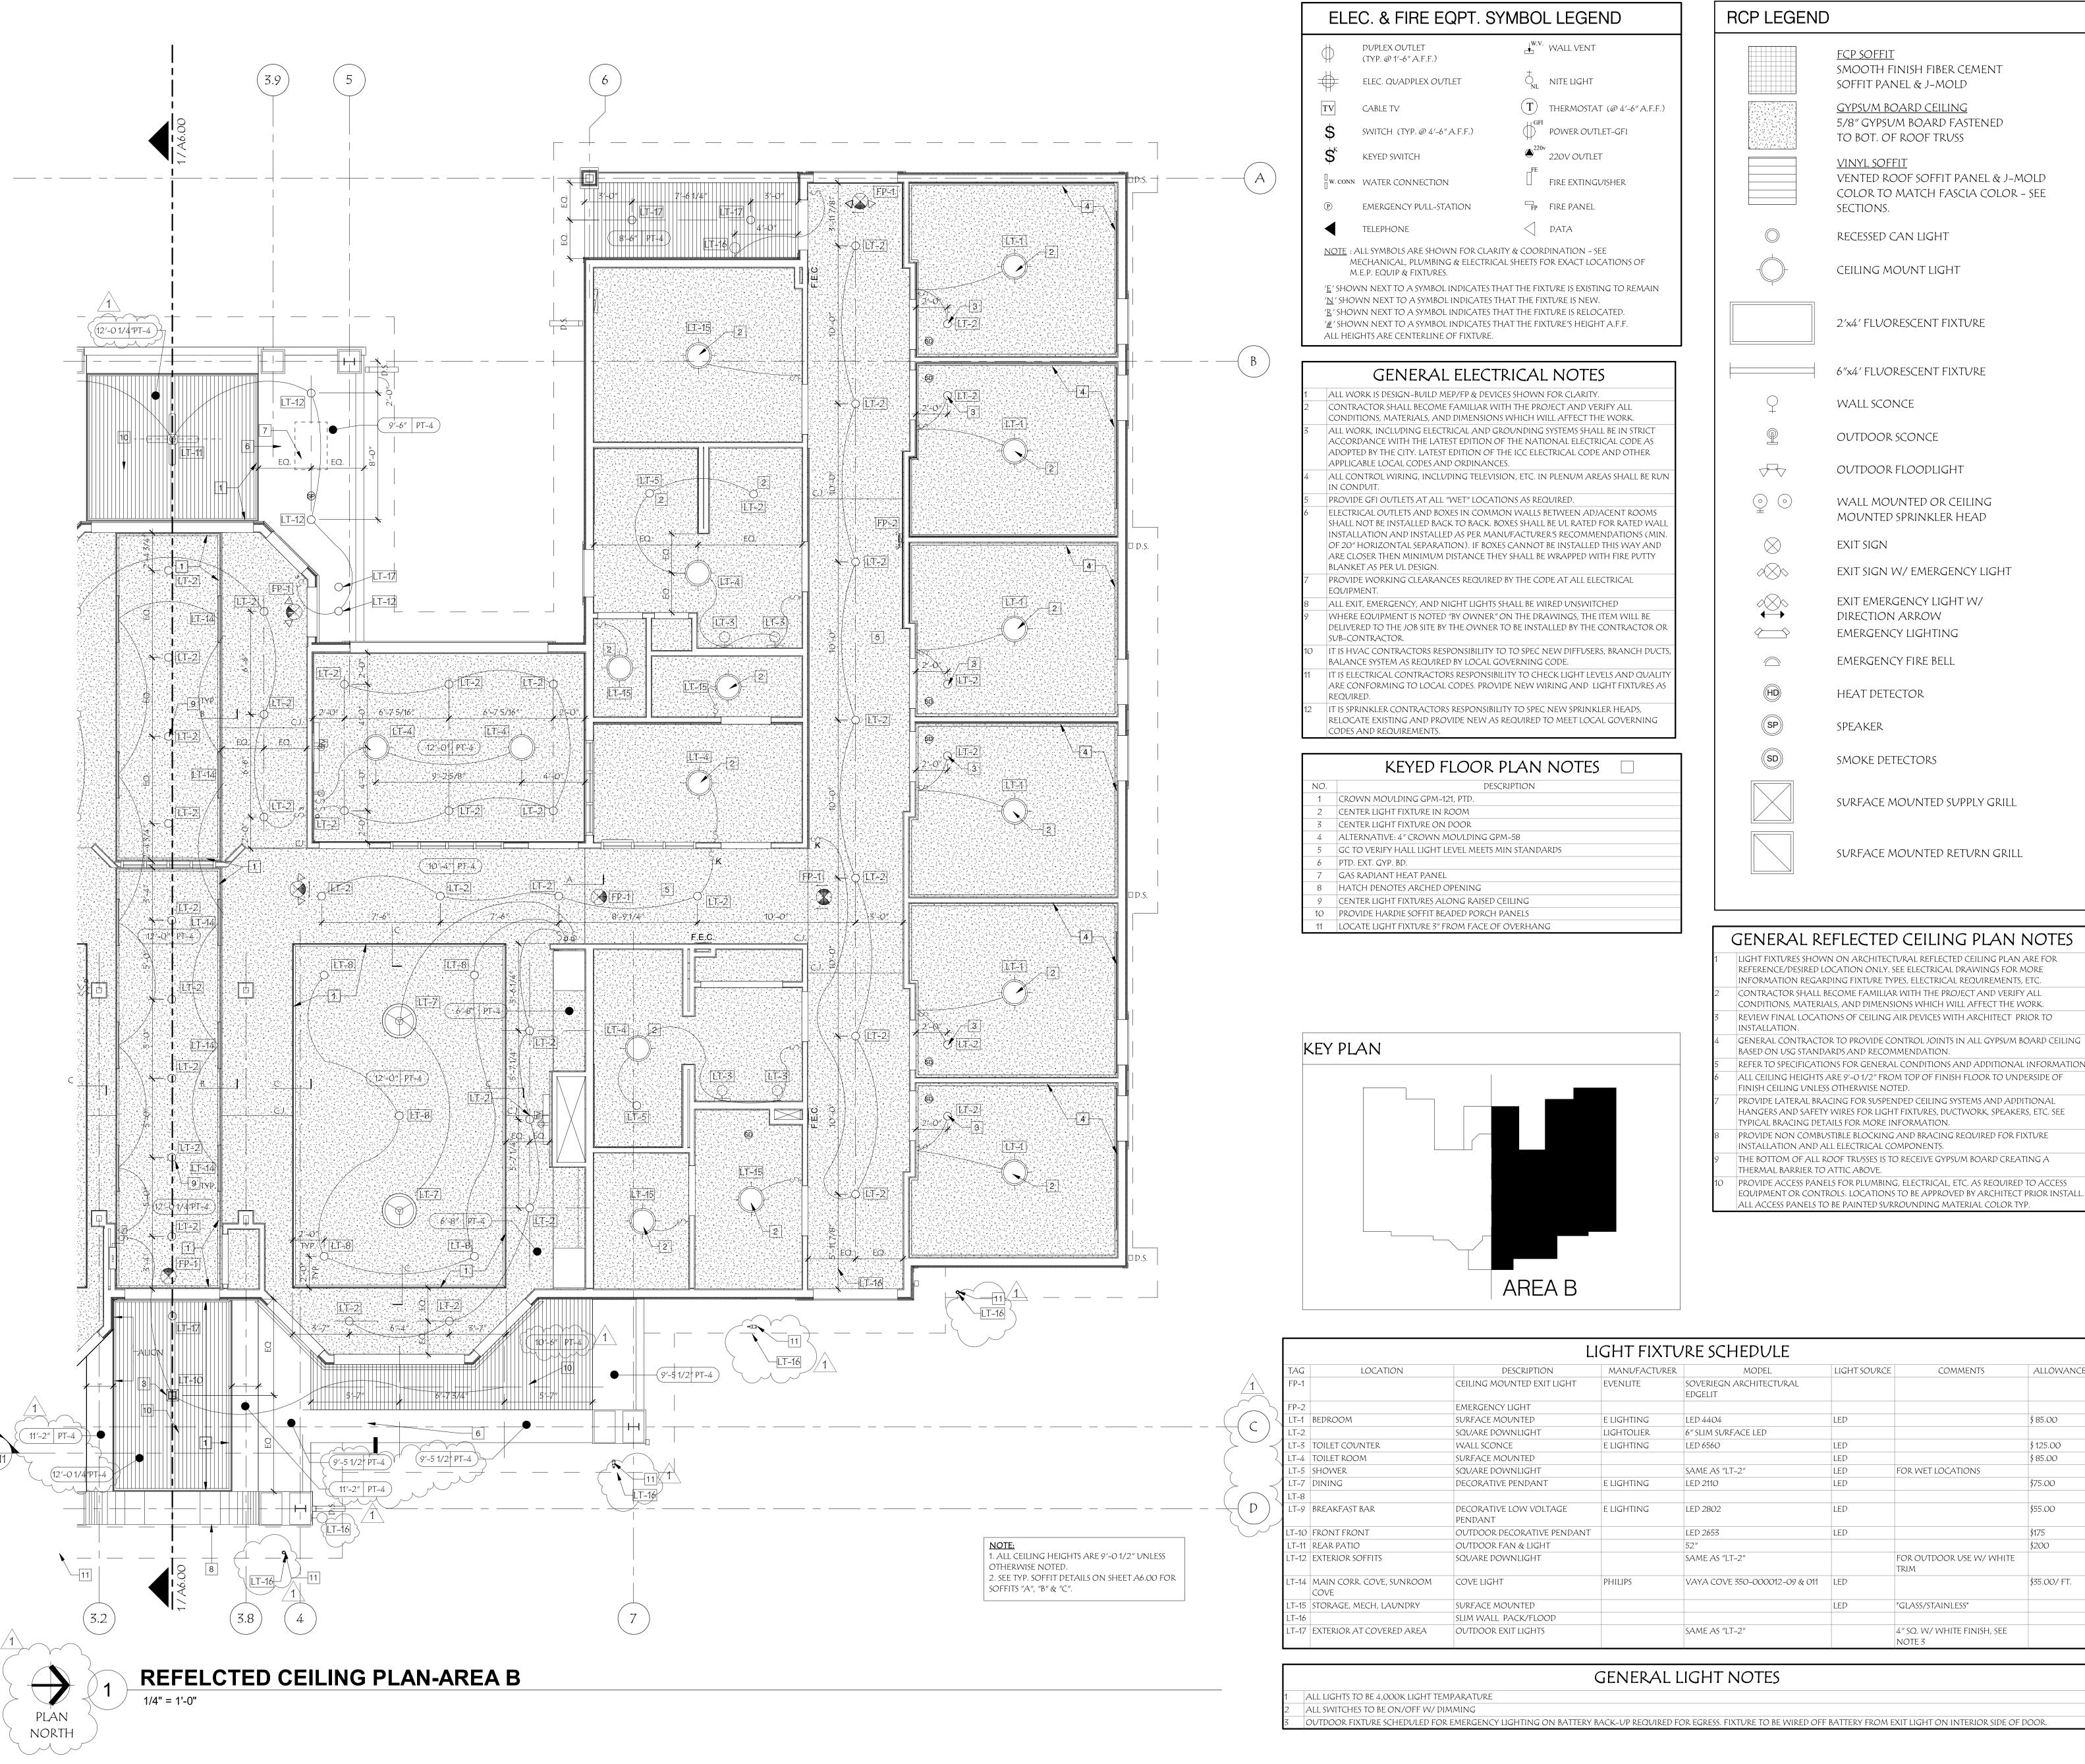


LOCATION	DESCRIPTION	MANUFACTURER	MODEL	LIGHT SOVRCE	COMMENTS	Allowance
	CEILING MOUNTED EXIT LIGHT	evenlite	SOVERIEGN ARCHITECTURAL			
			EDGELIT			
	EMERGENCY LIGHT					
DOM	SURFACE MOUNTED	E LIGHTING	LED 4404	LED		\$ 85.00
	SQVARE DOWNLIGHT	LIGHTOLIER	6" SLIM SURFACE LED			
T COUNTER	WALL SCONCE	e lighting	LED 6560	LED		\$125.00
T ROOM	SURFACE MOUNTED			LED		\$ 85.00
VER	SQVARE DOWNLIGHT		SAME AS "LT-2"	LED	FOR WET LOCATIONS	
IG	DECORATIVE PENDANT	e lighting	LED 2110	LED		\$75.00
KFAST BAR	DECORATIVE LOW VOLTAGE	e lighting	LED 2802	LED		\$55.00
	PENDANT					
TFRONT	OVTDOOR DECORATIVE PENDANT		LED 2653	LED		\$175
PATIO	OVTDOOR FAN & LIGHT		52″			\$200
RIOR SOFFITS	square downlight		SAME AS "LT-2"		FOR OUTDOOR USE W/ WHITE	
					IRIM	
I CORR. COVE, SVNROOM	COVE LIGHT	PHILIPS	VAYA COVE 350-000012-09 & 011	LED		\$35.00/ FT.
AGE, MECH, LAVNDRY	SURFACE MOUNTED			LED	*GLASS/STAINLESS*	
	SLIM WALL PACK/FLOOD					
RIOR AT COVERED AREA	OVTDOOR EXIT LIGHTS		SAME AS "LT-2"		4″ SQ. W/ WHITE FINISH, SEE	
					NOTE 3	
	DOM T COUNTER T ROOM VER IG KFAST BAR T FRONT PATIO NOR SOFFITS CORR. COVE, SUNROOM AGE, MECH, LAUNDRY	CEILING MOUNTED EXIT LIGHTEMERGENCY LIGHTDOMSURFACE MOUNTEDSQUARE DOWNLIGHTT COUNTERT ROOMSURFACE MOUNTEDVERSQUARE DOWNLIGHTIGDECORATIVE PENDANTKFAST BARPECORATIVE LOW VOLTAGEPENDANTT FRONTOUTDOOR DECORATIVE PENDANTVIDOR SOFFITSSQUARE DOWNLIGHTCORR. COVE, SUNROOMCOVE LIGHTAGE, MECH, LAUNDRYSURFACE MOUNTEDSLIM WALL PACK/FLOOD	CEILING MOUNTED EXIT LIGHTEVENLITEEMERGENCY LIGHTEVENLITEDOMSURFACE MOUNTEDE LIGHTINGSQUARE DOWNLIGHTLIGHTOLIERT COUNTERWALL SCONCEE LIGHTINGT ROOMSURFACE MOUNTEDIVERSQUARE DOWNLIGHTIIGDECORATIVE PENDANTE LIGHTINGKFAST BARDECORATIVE LOW VOLTAGE PENDANTE LIGHTINGT FRONTOUTDOOR DECORATIVE PENDANTEVARE DOWNLIGHTIIOUTDOOR FAN & LIGHTISQUARE DOWNLIGHTISQUARE DOWNLIGHTISUMFACE MOUNTEDISLIM WALL PACK/FLOODI	CEILING MOUNTED EXIT LIGHTEVENUITESOVERIEGN ARCHITECTURAL EPGELITEMERGENCY LIGHTEEEDGELITDOMSURFACE MOUNTEDELIGHTINGLED 4404SQUARE DOWNLIGHTLIGHTOLIER6" SLIM SURFACE LEDET COUNTERWALL SCONCEELIGHTINGLED 6560T ROOMSURFACE MOUNTEDELIGHTINGLED 6560YERSQUARE DOWNLIGHTSAME AS "LT-2"EIGDECORATIVE PENDANTELIGHTINGLED 2110KFAST BARDECORATIVE LOW VOLTAGE PENDANTELIGHTINGLED 2802YARDONOUTDOOR DECORATIVE PENDANTLED 2653ELIGHTINGJOR SOFFITSSQUARE DOWNLIGHT52"SAME AS "LT-2"CORR. COVE, SUNROOMCOVE LIGHTPHILIPSVAYA COVE 350-000012-09 & 011AGE, MECH, LAUNDRYSURFACE MOUNTEDSLIM WALL PACK/FLOODE	CEILING MOUNTED EXIT LIGHTEVENLITESOVERIEGN ARCHITECTURAL EDGELITEMERGENCY LIGHTEEDOMSURFACE MOUNTEDE LIGHTINGSQUARE DOWNLIGHTLIGHTOLIERMALL SCONCEE LIGHTINGLEDSOVERIEGN ARCHITECTURAL EDGELITCOUNTERWALL SCONCEVALLS CONCEE LIGHTINGLEDSURFACE MOUNTEDT ROOMSURFACE MOUNTEDKERSQUARE DOWNLIGHTLEDSAME AS "LT-2"LEDLEDGDECORATIVE PENDANTLEDLEDAGE, MECH, LAVNROMLED 2653LEDSQUARE DOWNLIGHTSQUARE DOWNLIGHTSAME AS "LT-2"LEDLEDAGE, MECH, LAVNROMLED 2653LEDSQUARE DOWNLIGHTCORR. COVE, SUNROOMCOVE LIGHTSQUARE DOWNLIGHTSAME AS "LT-2"LOR SOFFITSSQUARE DOWNLIGHTCORR. COVE, SUNROOMCOVE LIGHTSURFACE MOUNTEDLEDAGE, MECH, LAVNRYSURFACE MOUNTEDSLIM WALL PACK/FLOODLED	CEILING MOUNTED EXIT LIGHTEVENLITESOVERIEGN ARCHITECTURAL EDGELITInitial ConstructionEMERGENCY LIGHTEIEDIEDDOMSURFACE MOUNTEDEIED HIGHTINGIED 4404IEDSQUARE DOWNLIGHTILGHTOLIER6" SLIM SURFACE LEDIEDIEDT COUNTERWALL SCONCEEILGHTINGIED 6560IEDT ROOMSURFACE MOUNTEDIED 6560IEDIEDKERSQUARE DOWNLIGHTESAME AS "LT-2"IEDIGDECORATIVE PENDANTEILGHTINGIED 210IEDKFAST BARDECORATIVE PENDANTEILGHTINGIED 2802IEDT FRONTOUTDOOR DECORATIVE PENDANTIED 2653IEDIEDATIOOUTDOOR FAN & LIGHTSAME AS "LT-2"IEDFOR OUTDOOR USE W/ WHITEAGE SOLARE DOWNLIGHTIED 2653IEDIEDIEDAGE NOLARE DOWNLIGHTSAME AS "LT-2"IEDFOR OUTDOOR USE W/ WHITEAGE, MECH, LAUNDRYSURFACE MOUNTEDSAME AS "LT-2"IEDIEDAGE, MECH, LAUNDRYSURFACE MOUNTEDIEDIEDIEDIEDSIDM WALL PACK/FLOODIEDIEDIEDIEDIEDSIDM WALL PACK/FLOODIEDIEDIEDIEDIEDSIDM WALL PACK/FLOODIEDIEDIEDIEDIEDSIDM WALL PACK/FLOODIEDIEDIEDIEDIEDSIDM WALL PACK/FLOODIEDIEDIEDIEDIEDSID

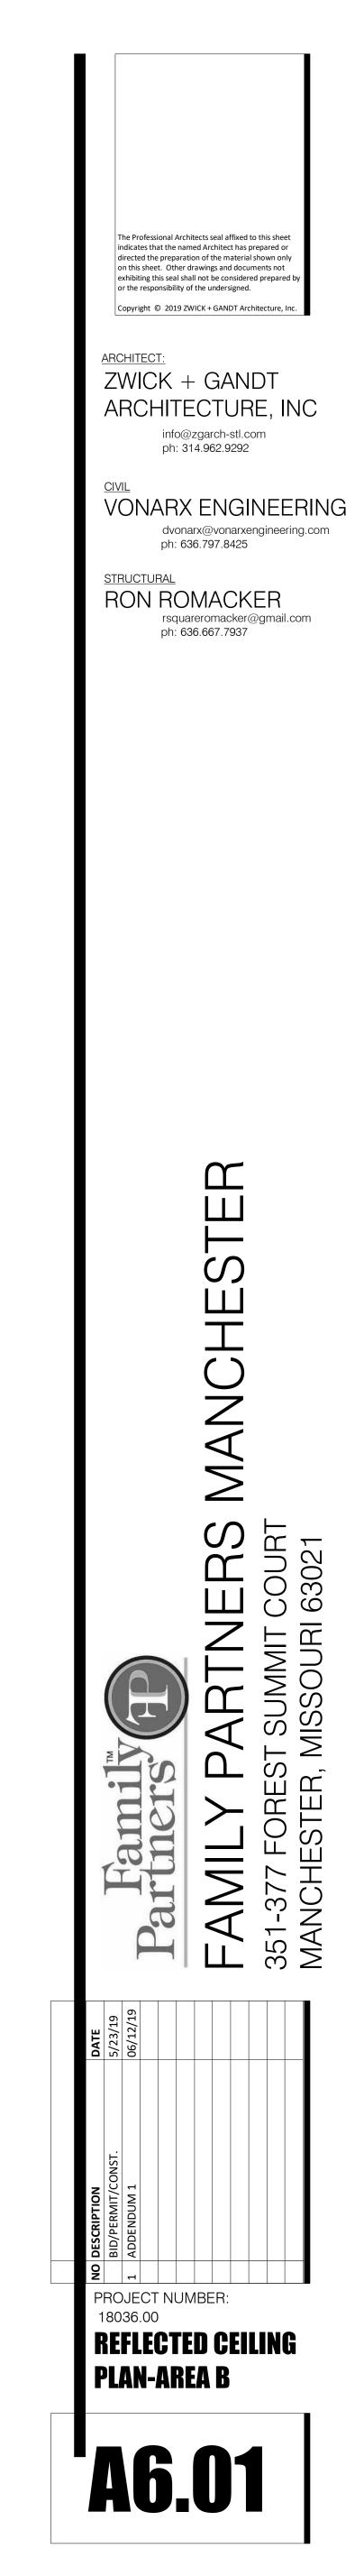


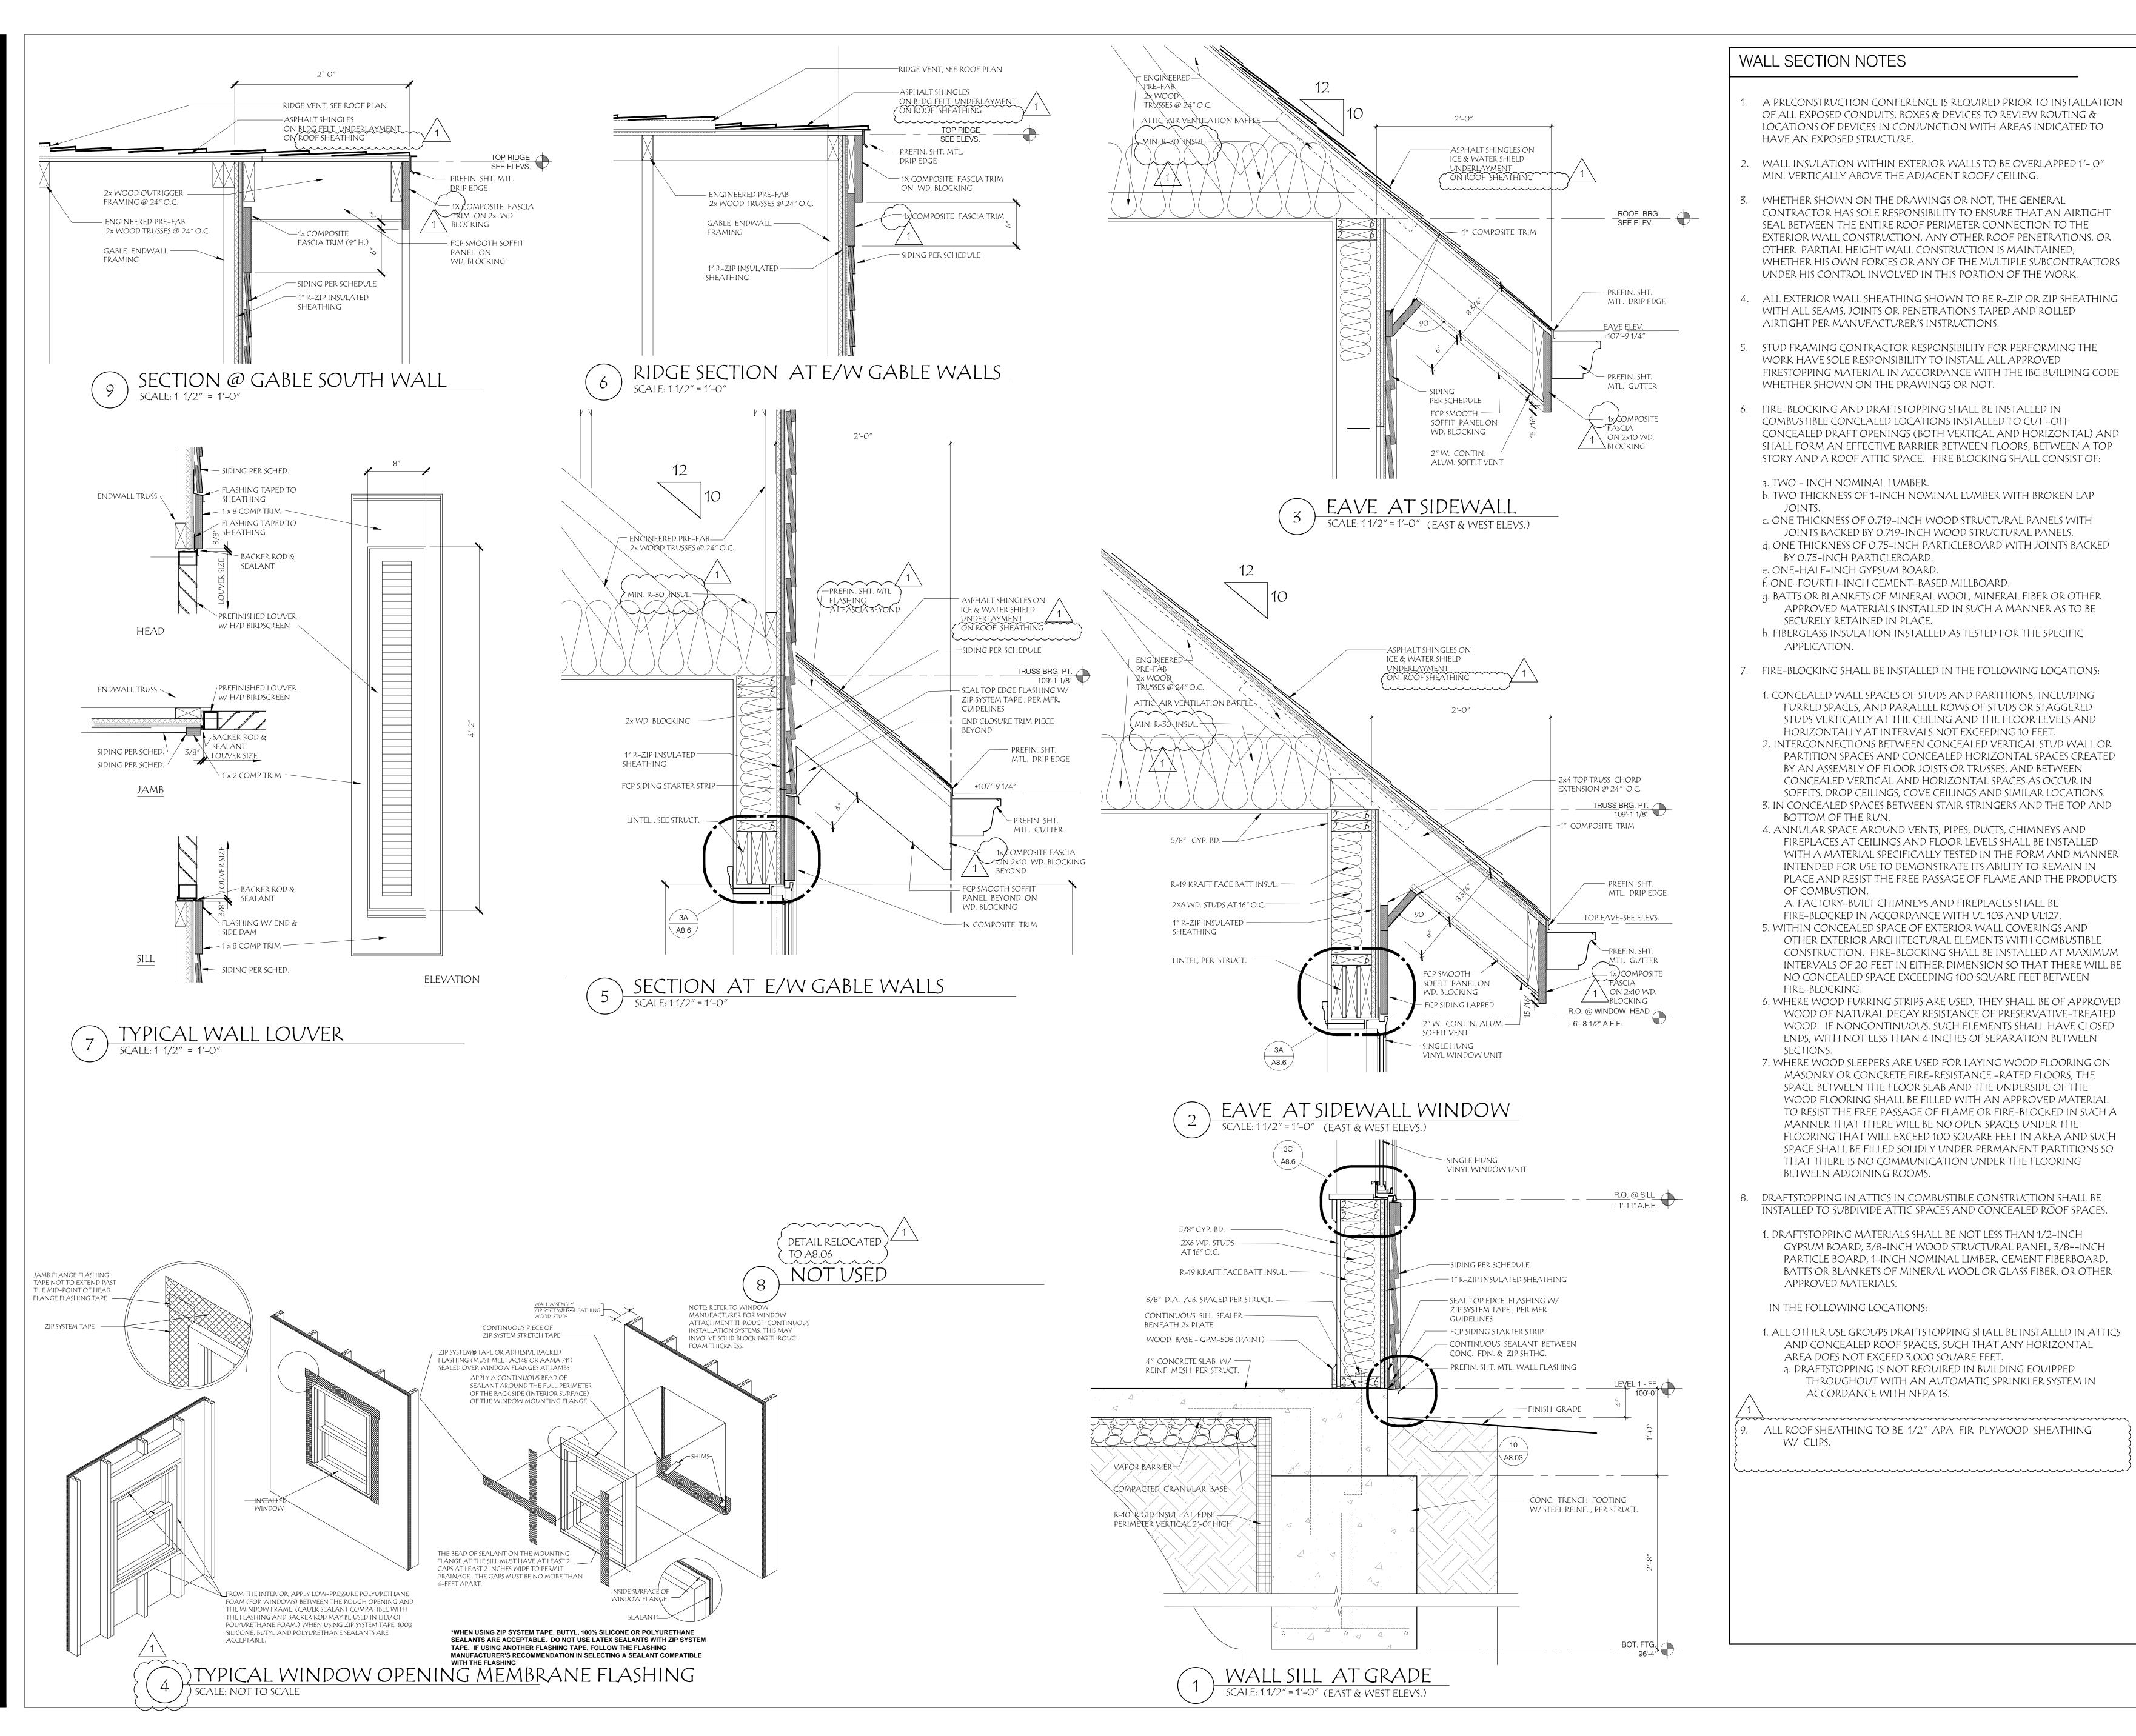


/13/2019 2:02 PM



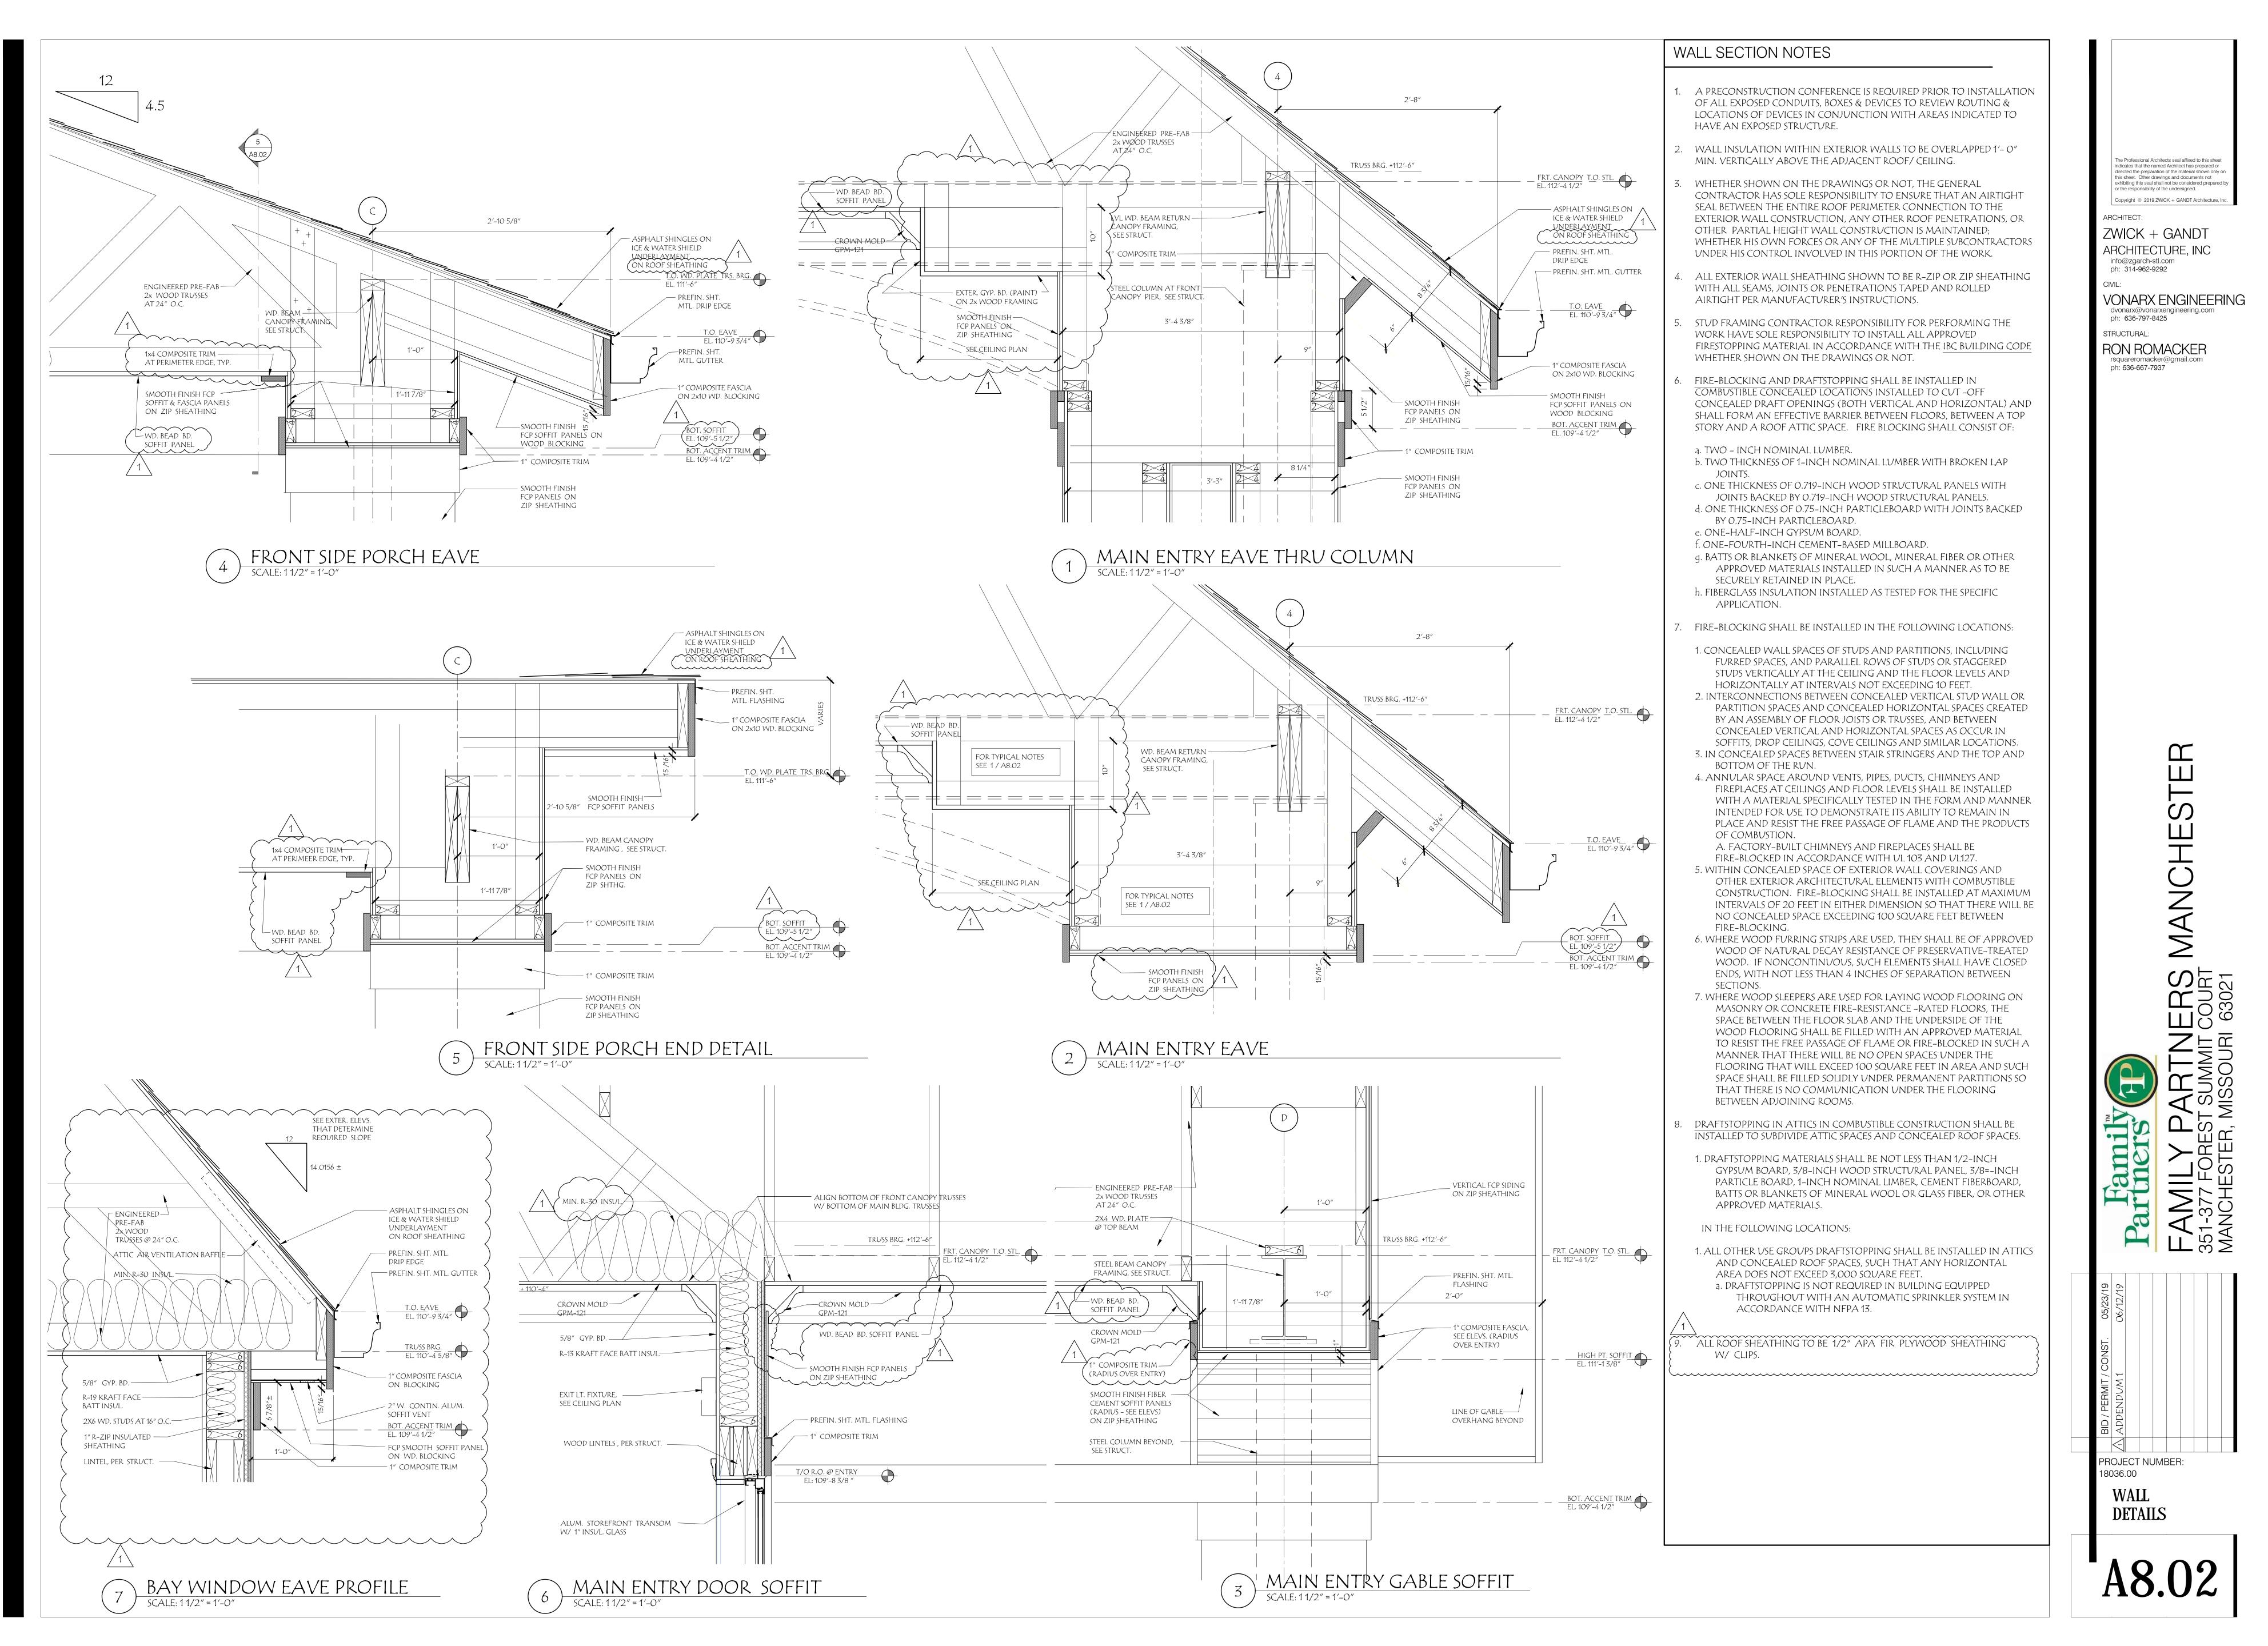

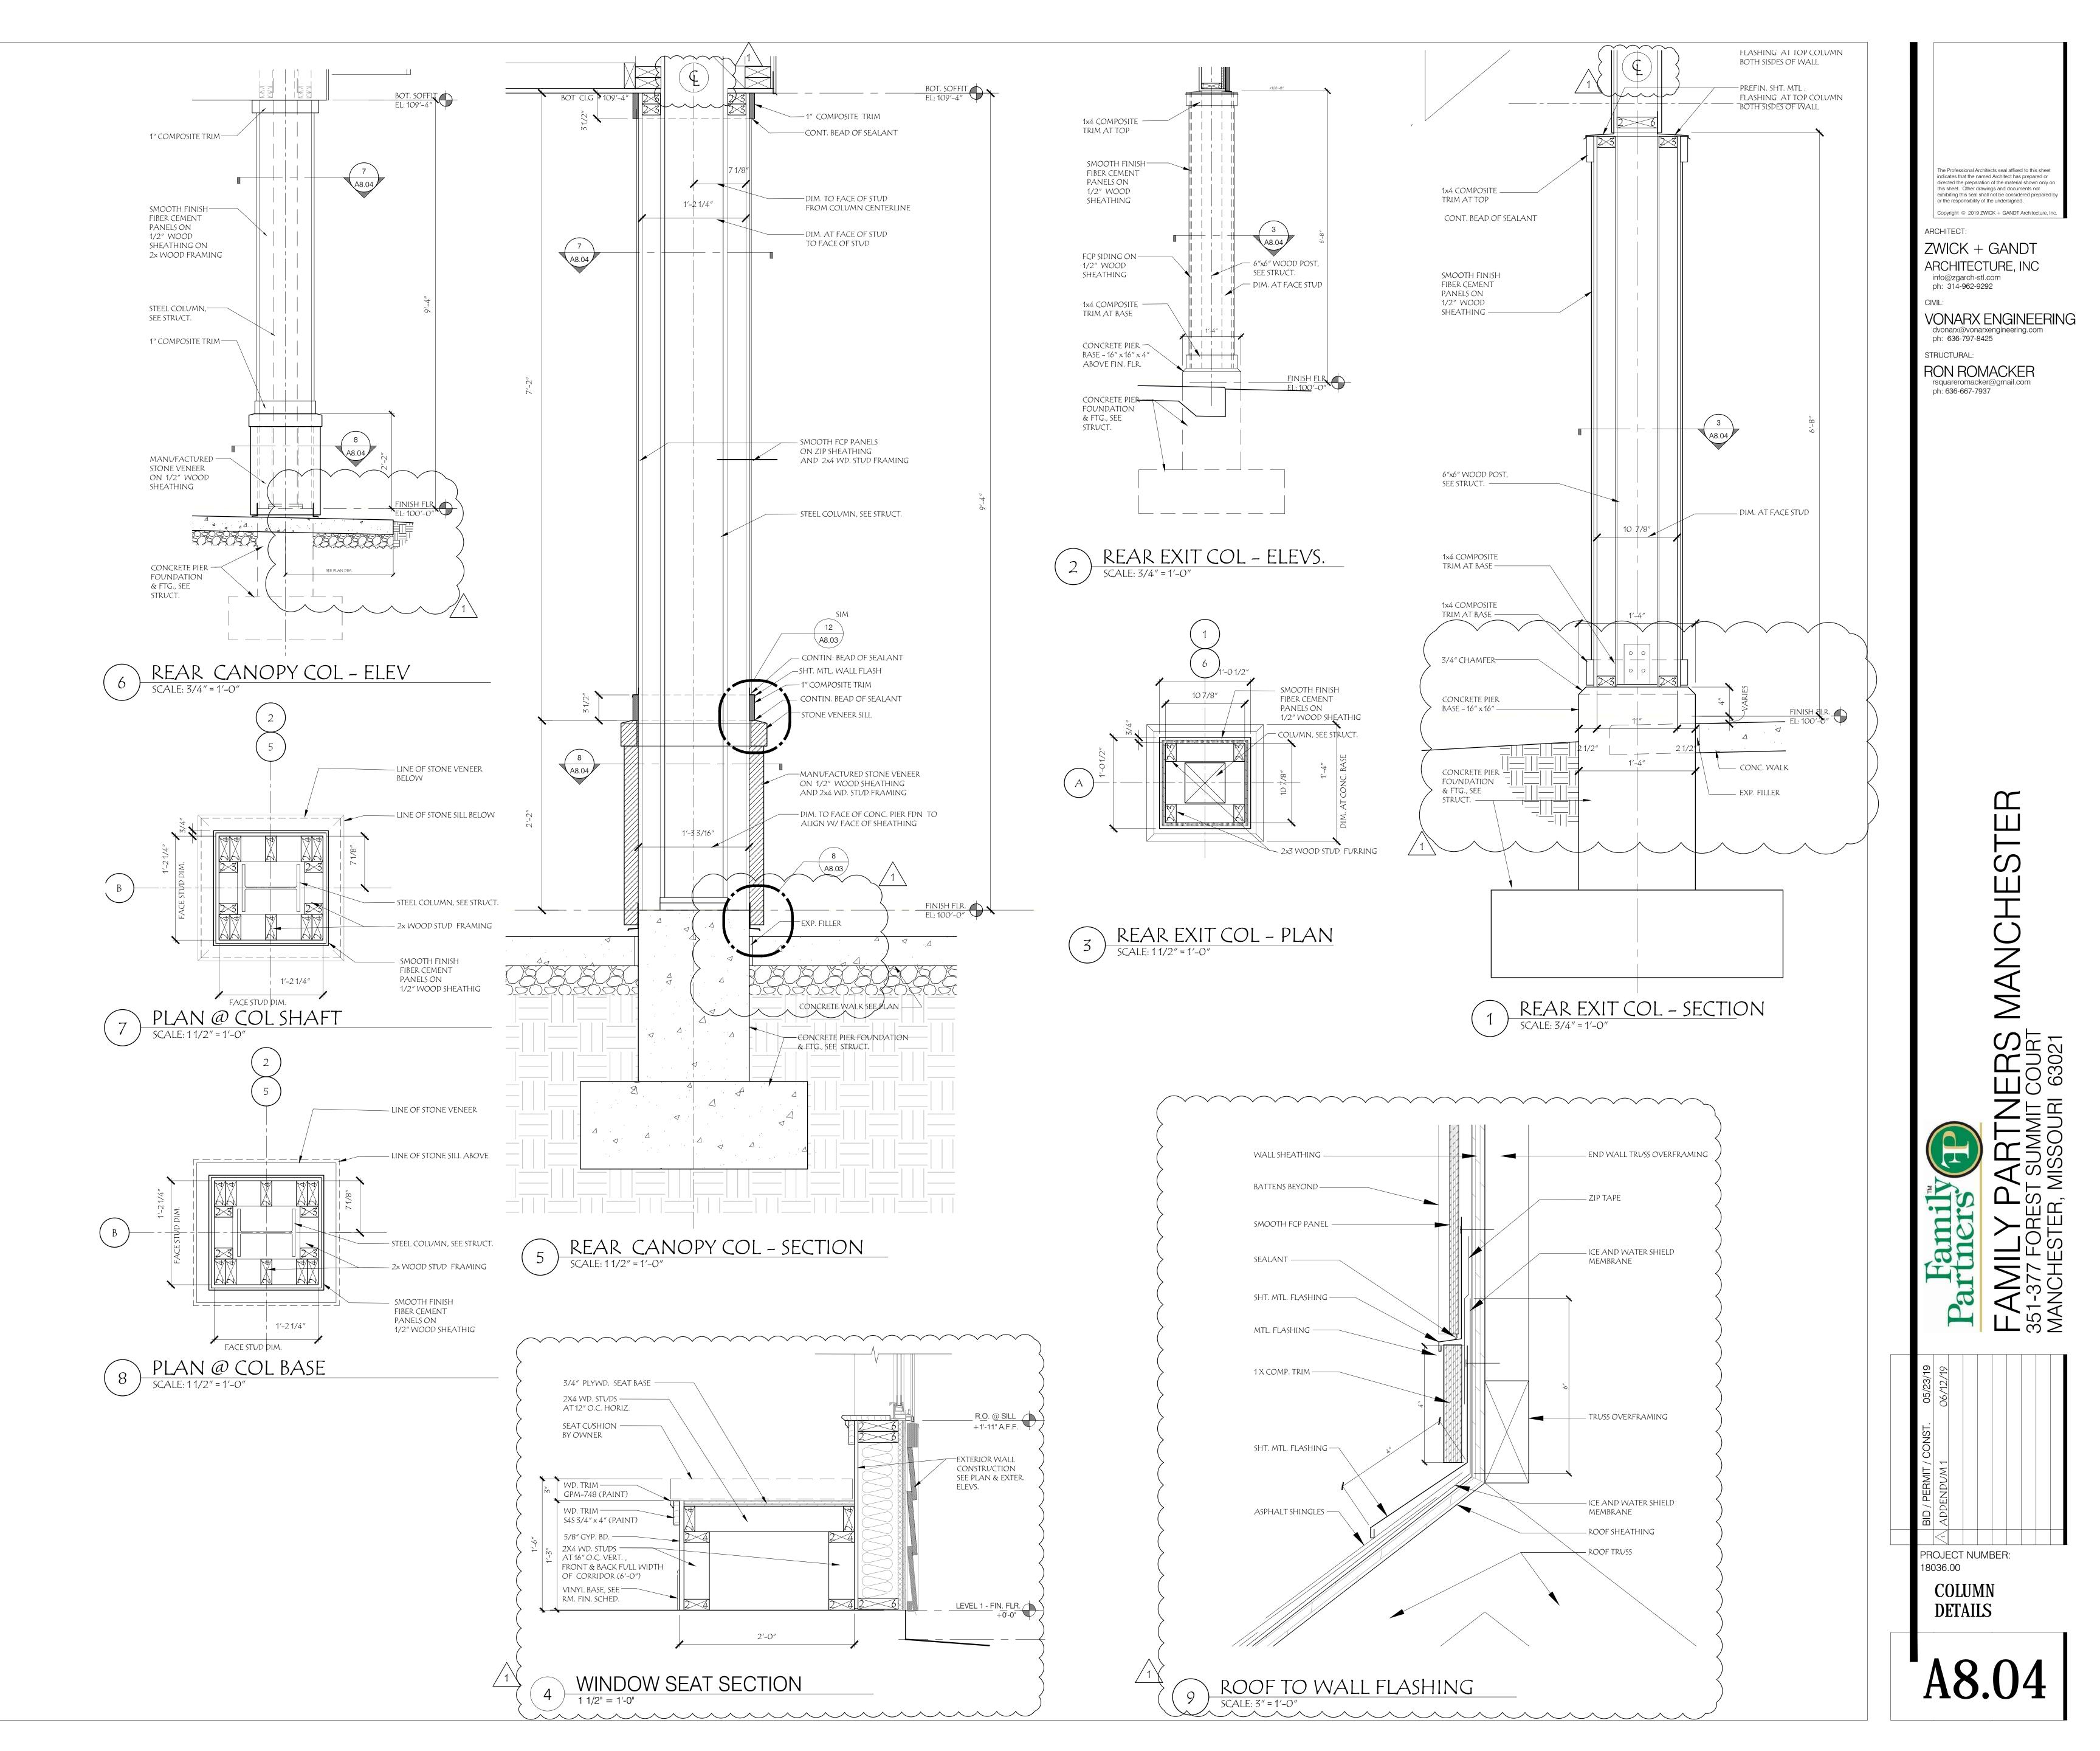

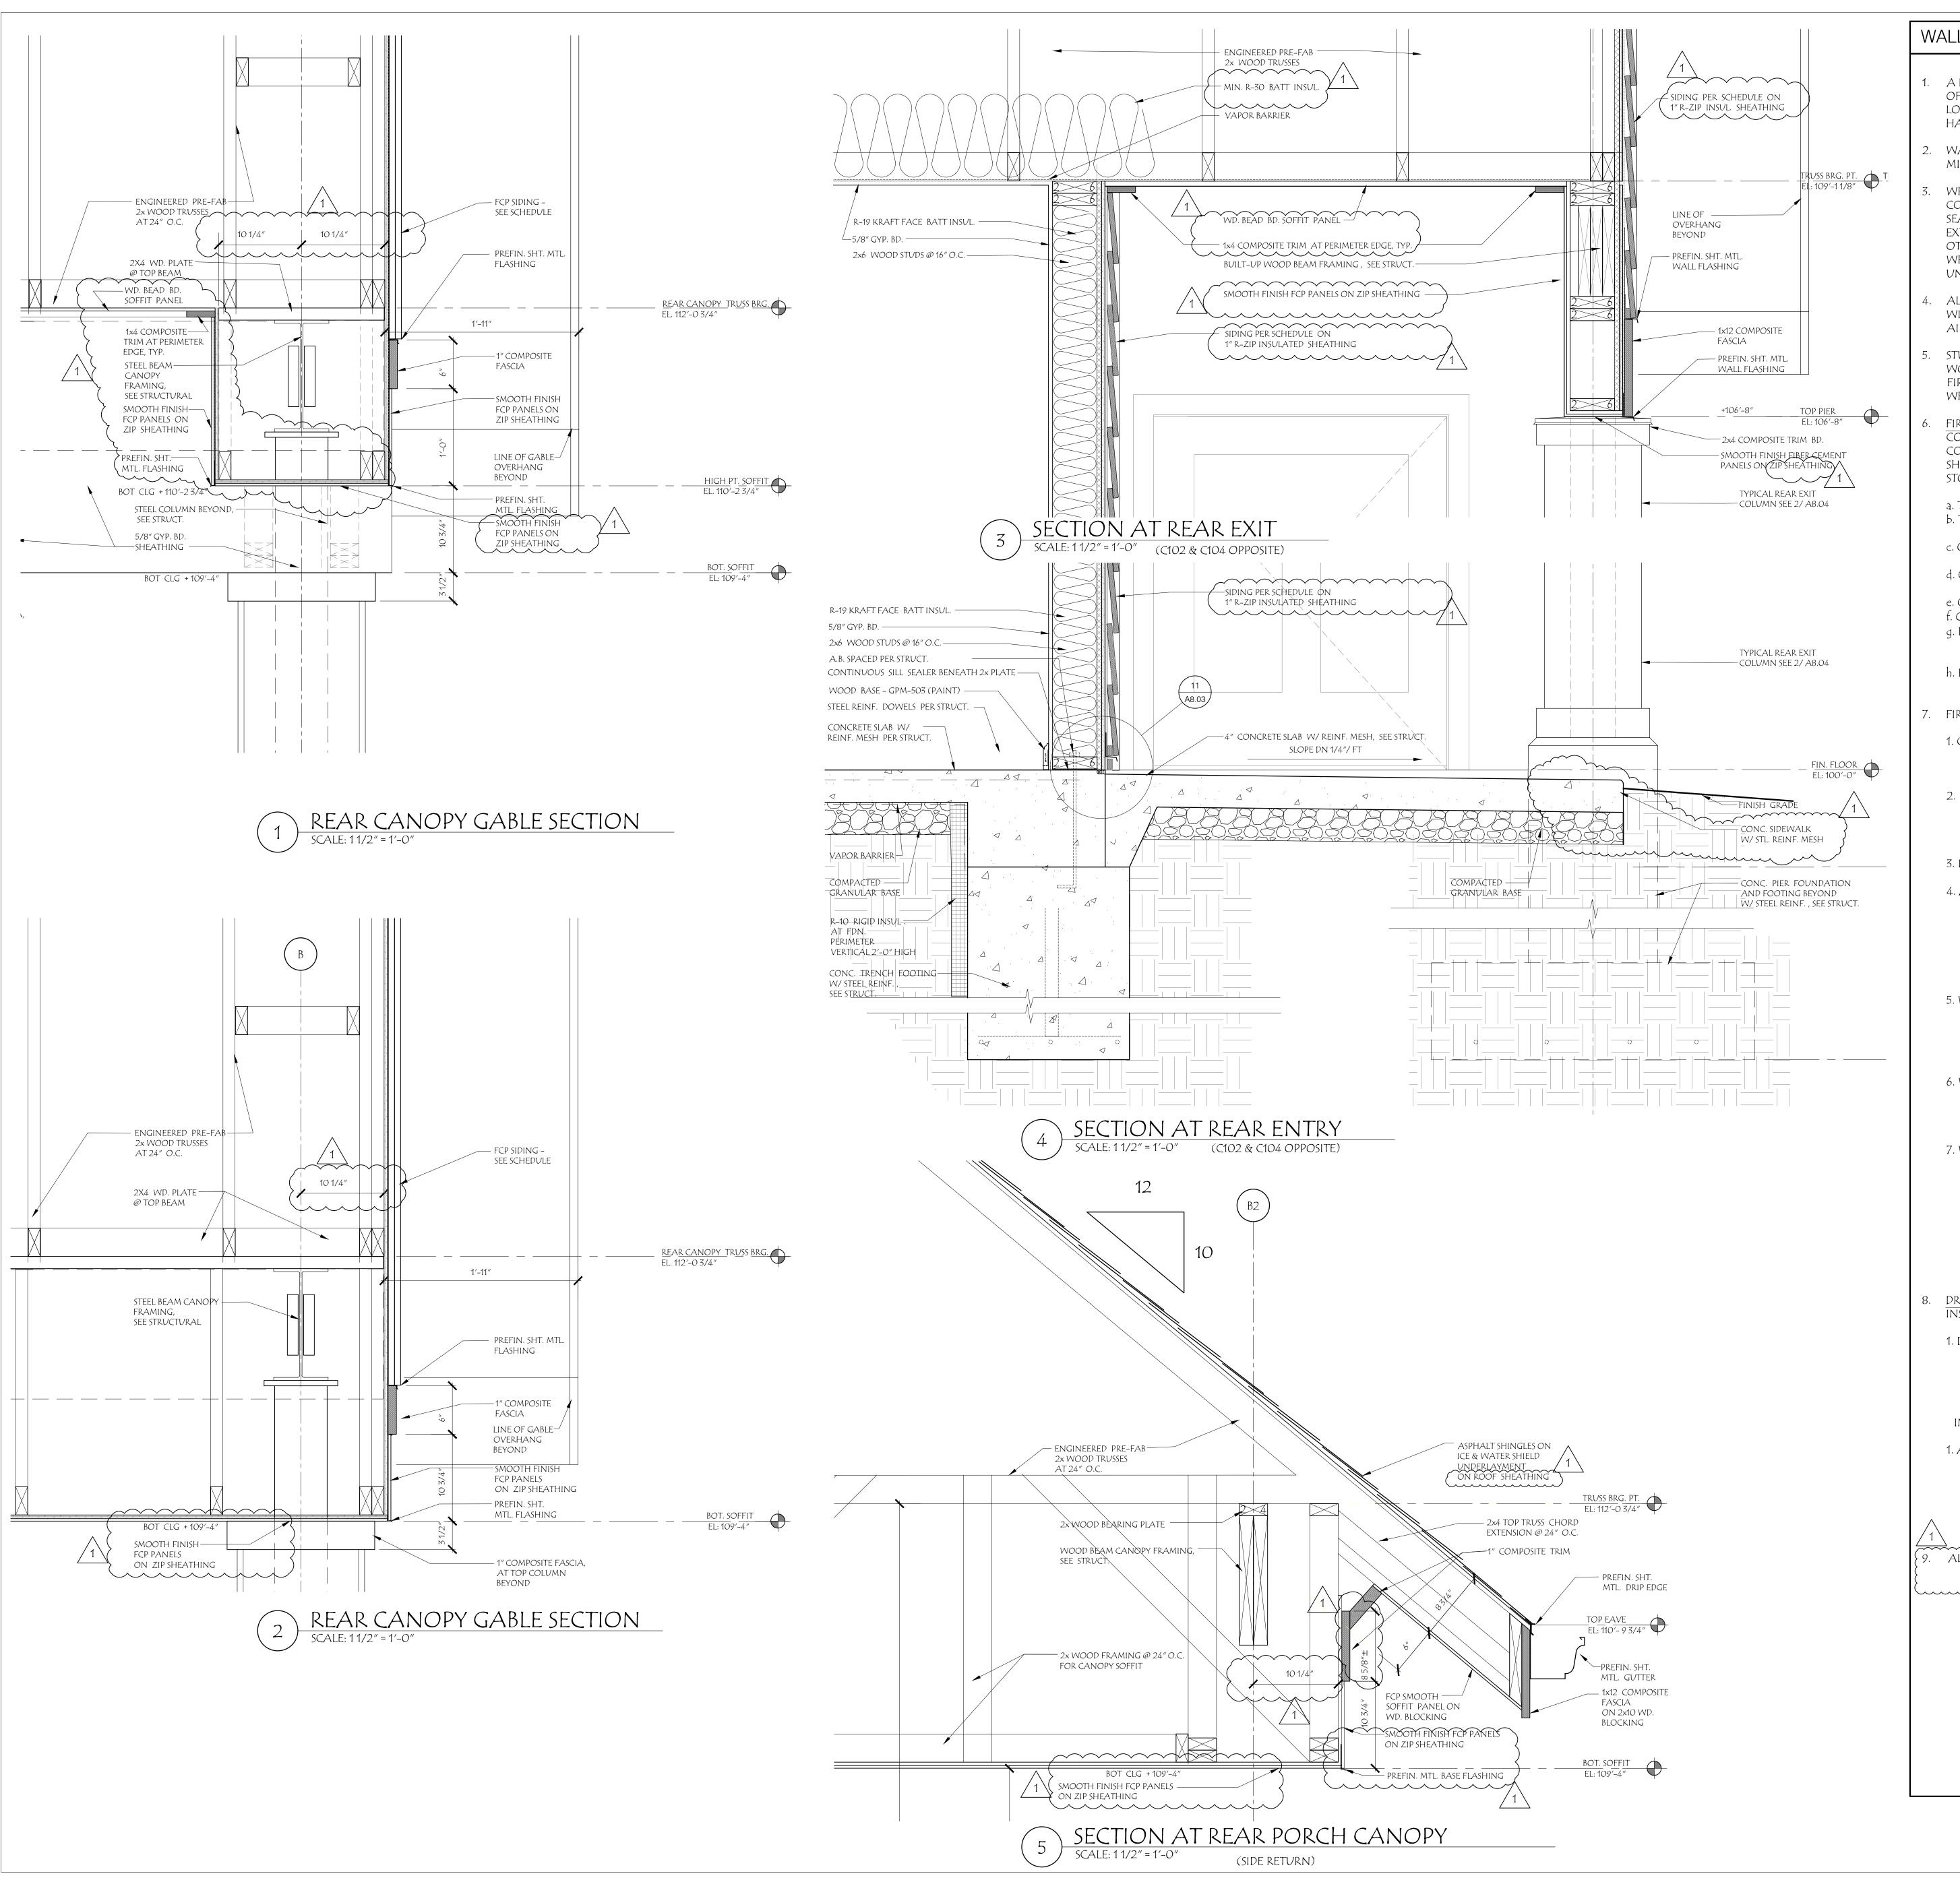



## WALL SECTION NOTES

- 1. A PRECONSTRUCTION CONFERENCE IS REQUIRED PRIOR TO INSTALLATION OF ALL EXPOSED CONDUITS, BOXES & DEVICES TO REVIEW ROUTING & LOCATIONS OF DEVICES IN CONJUNCTION WITH AREAS INDICATED TO HAVE AN EXPOSED STRUCTURE.
- 2. WALL INSULATION WITHIN EXTERIOR WALLS TO BE OVERLAPPED 1'- O" MIN. VERTICALLY ABOVE THE ADJACENT ROOF/ CEILING.
- 3. WHETHER SHOWN ON THE DRAWINGS OR NOT, THE GENERAL CONTRACTOR HAS SOLE RESPONSIBILITY TO ENSURE THAT AN AIRTIGHT SEAL BETWEEN THE ENTIRE ROOF PERIMETER CONNECTION TO THE EXTERIOR WALL CONSTRUCTION, ANY OTHER ROOF PENETRATIONS, OR OTHER PARTIAL HEIGHT WALL CONSTRUCTION IS MAINTAINED; WHETHER HIS OWN FORCES OR ANY OF THE MULTIPLE SUBCONTRACTORS UNDER HIS CONTROL INVOLVED IN THIS PORTION OF THE WORK.
- 4. ALL EXTERIOR WALL SHEATHING SHOWN TO BE R-ZIP OR ZIP SHEATHING WITH ALL SEAMS, JOINTS OR PENETRATIONS TAPED AND ROLLED AIRTIGHT PER MANUFACTURER'S INSTRUCTIONS.
- 5. STUD FRAMING CONTRACTOR RESPONSIBILITY FOR PERFORMING THE WORK HAVE SOLE RESPONSIBILITY TO INSTALL ALL APPROVED FIRESTOPPING MATERIAL IN ACCORDANCE WITH THE IBC BUILDING CODE WHETHER SHOWN ON THE DRAWINGS OR NOT.
- 5. FIRE-BLOCKING AND DRAFTSTOPPING SHALL BE INSTALLED IN COMBUSTIBLE CONCEALED LOCATIONS INSTALLED TO CVT -OFF CONCEALED DRAFT OPENINGS (BOTH VERTICAL AND HORIZONTAL) AND SHALL FORM AN EFFECTIVE BARRIER BETWEEN FLOORS, BETWEEN A TOP STORY AND A ROOF ATTIC SPACE. FIRE BLOCKING SHALL CONSIST OF:
- a. TWO INCH NOMINAL LUMBER.
- b. TWO THICKNESS OF 1-INCH NOMINAL LUMBER WITH BROKEN LAP JOINTS.
   c. ONE THICKNESS OF 0.719-INCH WOOD STRUCTURAL PANELS WITH
- JOINTS BACKED BY 0.719-INCH WOOD STRUCTURAL PANELS. d. ONE THICKNESS OF 0.75-INCH PARTICLEBOARD WITH JOINTS BACKED
- BY 0.75-INCH PARTICLEBOARD.
- e. ONE-HALF-INCH GYPSVM BOARD. f. ONE-FOVRTH-INCH CEMENT-BASED MILLBOARD.
- g. BATTS OR BLANKETS OF MINERAL WOOL, MINERAL FIBER OR OTHER APPROVED MATERIALS INSTALLED IN SUCH A MANNER AS TO BE SECURELY RETAINED IN PLACE.
- h. FIBERGLASS INSULATION INSTALLED AS TESTED FOR THE SPECIFIC APPLICATION.
- 7. FIRE-BLOCKING SHALL BE INSTALLED IN THE FOLLOWING LOCATIONS:
- 1. CONCEALED WALL SPACES OF STUDS AND PARTITIONS, INCLUDING FURRED SPACES, AND PARALLEL ROWS OF STUDS OR STAGGERED STUDS VERTICALLY AT THE CEILING AND THE FLOOR LEVELS AND
- STUDS VERTICALLY AT THE CEILING AND THE FLOOK LEVELS AND HORIZONTALLY AT INTERVALS NOT EXCEEDING 10 FEET.
  2. INTERCONNECTIONS BETWEEN CONCEALED VERTICAL STUD WALL OR PARTITION SPACES AND CONCEALED HORIZONTAL SPACES CREATED BY AN ASSEMBLY OF FLOOR JOISTS OR TRUSSES, AND BETWEEN CONCEALED VERTICAL AND HORIZONTAL SPACES AS OCCUR IN SOFFITS, DROP CEILINGS, COVE CEILINGS AND SIMILAR LOCATIONS.
- 3. IN CONCEALED SPACES BETWEEN STAIR STRINGERS AND THE TOP AND BOTTOM OF THE RUN.
   4. ANNULAR SPACE AROUND VENITS, DIRES, DUCTS, CHIMNEYS, AND
- 4. ANNULAR SPACE AROUND VENTS, PIPES, DUCTS, CHIMNEYS AND FIREPLACES AT CEILINGS AND FLOOR LEVELS SHALL BE INSTALLED WITH A MATERIAL SPECIFICALLY TESTED IN THE FORM AND MANNER INTENDED FOR USE TO DEMONSTRATE ITS ABILITY TO REMAIN IN PLACE AND RESIST THE FREE PASSAGE OF FLAME AND THE PRODUCTS OF COMBUSTION. A. FACTORY-BUILT CHIMNEYS AND FIREPLACES SHALL BE
- FIRE-BLOCKED IN ACCORDANCE WITH VL 103 AND VL127.
  WITHIN CONCEALED SPACE OF EXTERIOR WALL COVERINGS AND OTHER EXTERIOR ARCHITECTURAL ELEMENTS WITH COMBUSTIBLE CONSTRUCTION. FIRE-BLOCKING SHALL BE INSTALLED AT MAXIMUM INTERVALS OF 20 FEET IN EITHER DIMENSION SO THAT THERE WILL BE NO CONCEALED SPACE EXCEEDING 100 SQUARE FEET BETWEEN FIRE-BLOCKING.
- WHERE WOOD FURRING STRIPS ARE USED, THEY SHALL BE OF APPROVED WOOD OF NATURAL DECAY RESISTANCE OF PRESERVATIVE-TREATED WOOD. IF NONCONTINUOUS, SUCH ELEMENTS SHALL HAVE CLOSED ENDS, WITH NOT LESS THAN 4 INCHES OF SEPARATION BETWEEN SECTIONS.
- 7. WHERE WOOD SLEEPERS ARE USED FOR LAYING WOOD FLOORING ON MASONRY OR CONCRETE FIRE-RESISTANCE -RATED FLOORS, THE SPACE BETWEEN THE FLOOR SLAB AND THE UNDERSIDE OF THE WOOD FLOORING SHALL BE FILLED WITH AN APPROVED MATERIAL TO RESIST THE FREE PASSAGE OF FLAME OR FIRE-BLOCKED IN SUCH A MANNER THAT THERE WILL BE NO OPEN SPACES UNDER THE FLOORING THAT WILL EXCEED 100 SQUARE FEET IN AREA AND SUCH SPACE SHALL BE FILLED SOLIDLY UNDER PERMANENT PARTITIONS SO THAT THERE IS NO COMMUNICATION UNDER THE FLOORING BETWEEN ADJOINING ROOMS.
- 8. DRAFTSTOPPING IN ATTICS IN COMBUSTIBLE CONSTRUCTION SHALL BE INSTALLED TO SUBDIVIDE ATTIC SPACES AND CONCEALED ROOF SPACES.
- 1. DRAFTSTOPPING MATERIALS SHALL BE NOT LESS THAN 1/2-INCH GYPSUM BOARD, 3/8-INCH WOOD STRUCTURAL PANEL, 3/8=-INCH PARTICLE BOARD, 1-INCH NOMINAL LIMBER, CEMENT FIBERBOARD, BATTS OR BLANKETS OF MINERAL WOOL OR GLASS FIBER, OR OTHER APPROVED MATERIALS.
- IN THE FOLLOWING LOCATIONS
- ALL OTHER USE GROUPS DRAFTSTOPPING SHALL BE INSTALLED IN ATTICS AND CONCEALED ROOF SPACES, SUCH THAT ANY HORIZONTAL AREA DOES NOT EXCEED 3,000 SQUARE FEET.
   a. DRAFTSTOPPING IS NOT REQUIRED IN BUILDING EQUIPPED THROUGHOUT WITH AN AUTOMATIC SPRINKLER SYSTEM IN ACCORDANCE WITH NFPA 13.

9. All ROOF SHEATHING TO BE 1/2" APA FIR PLYWOOD SHEATHING W/ CLIPS.



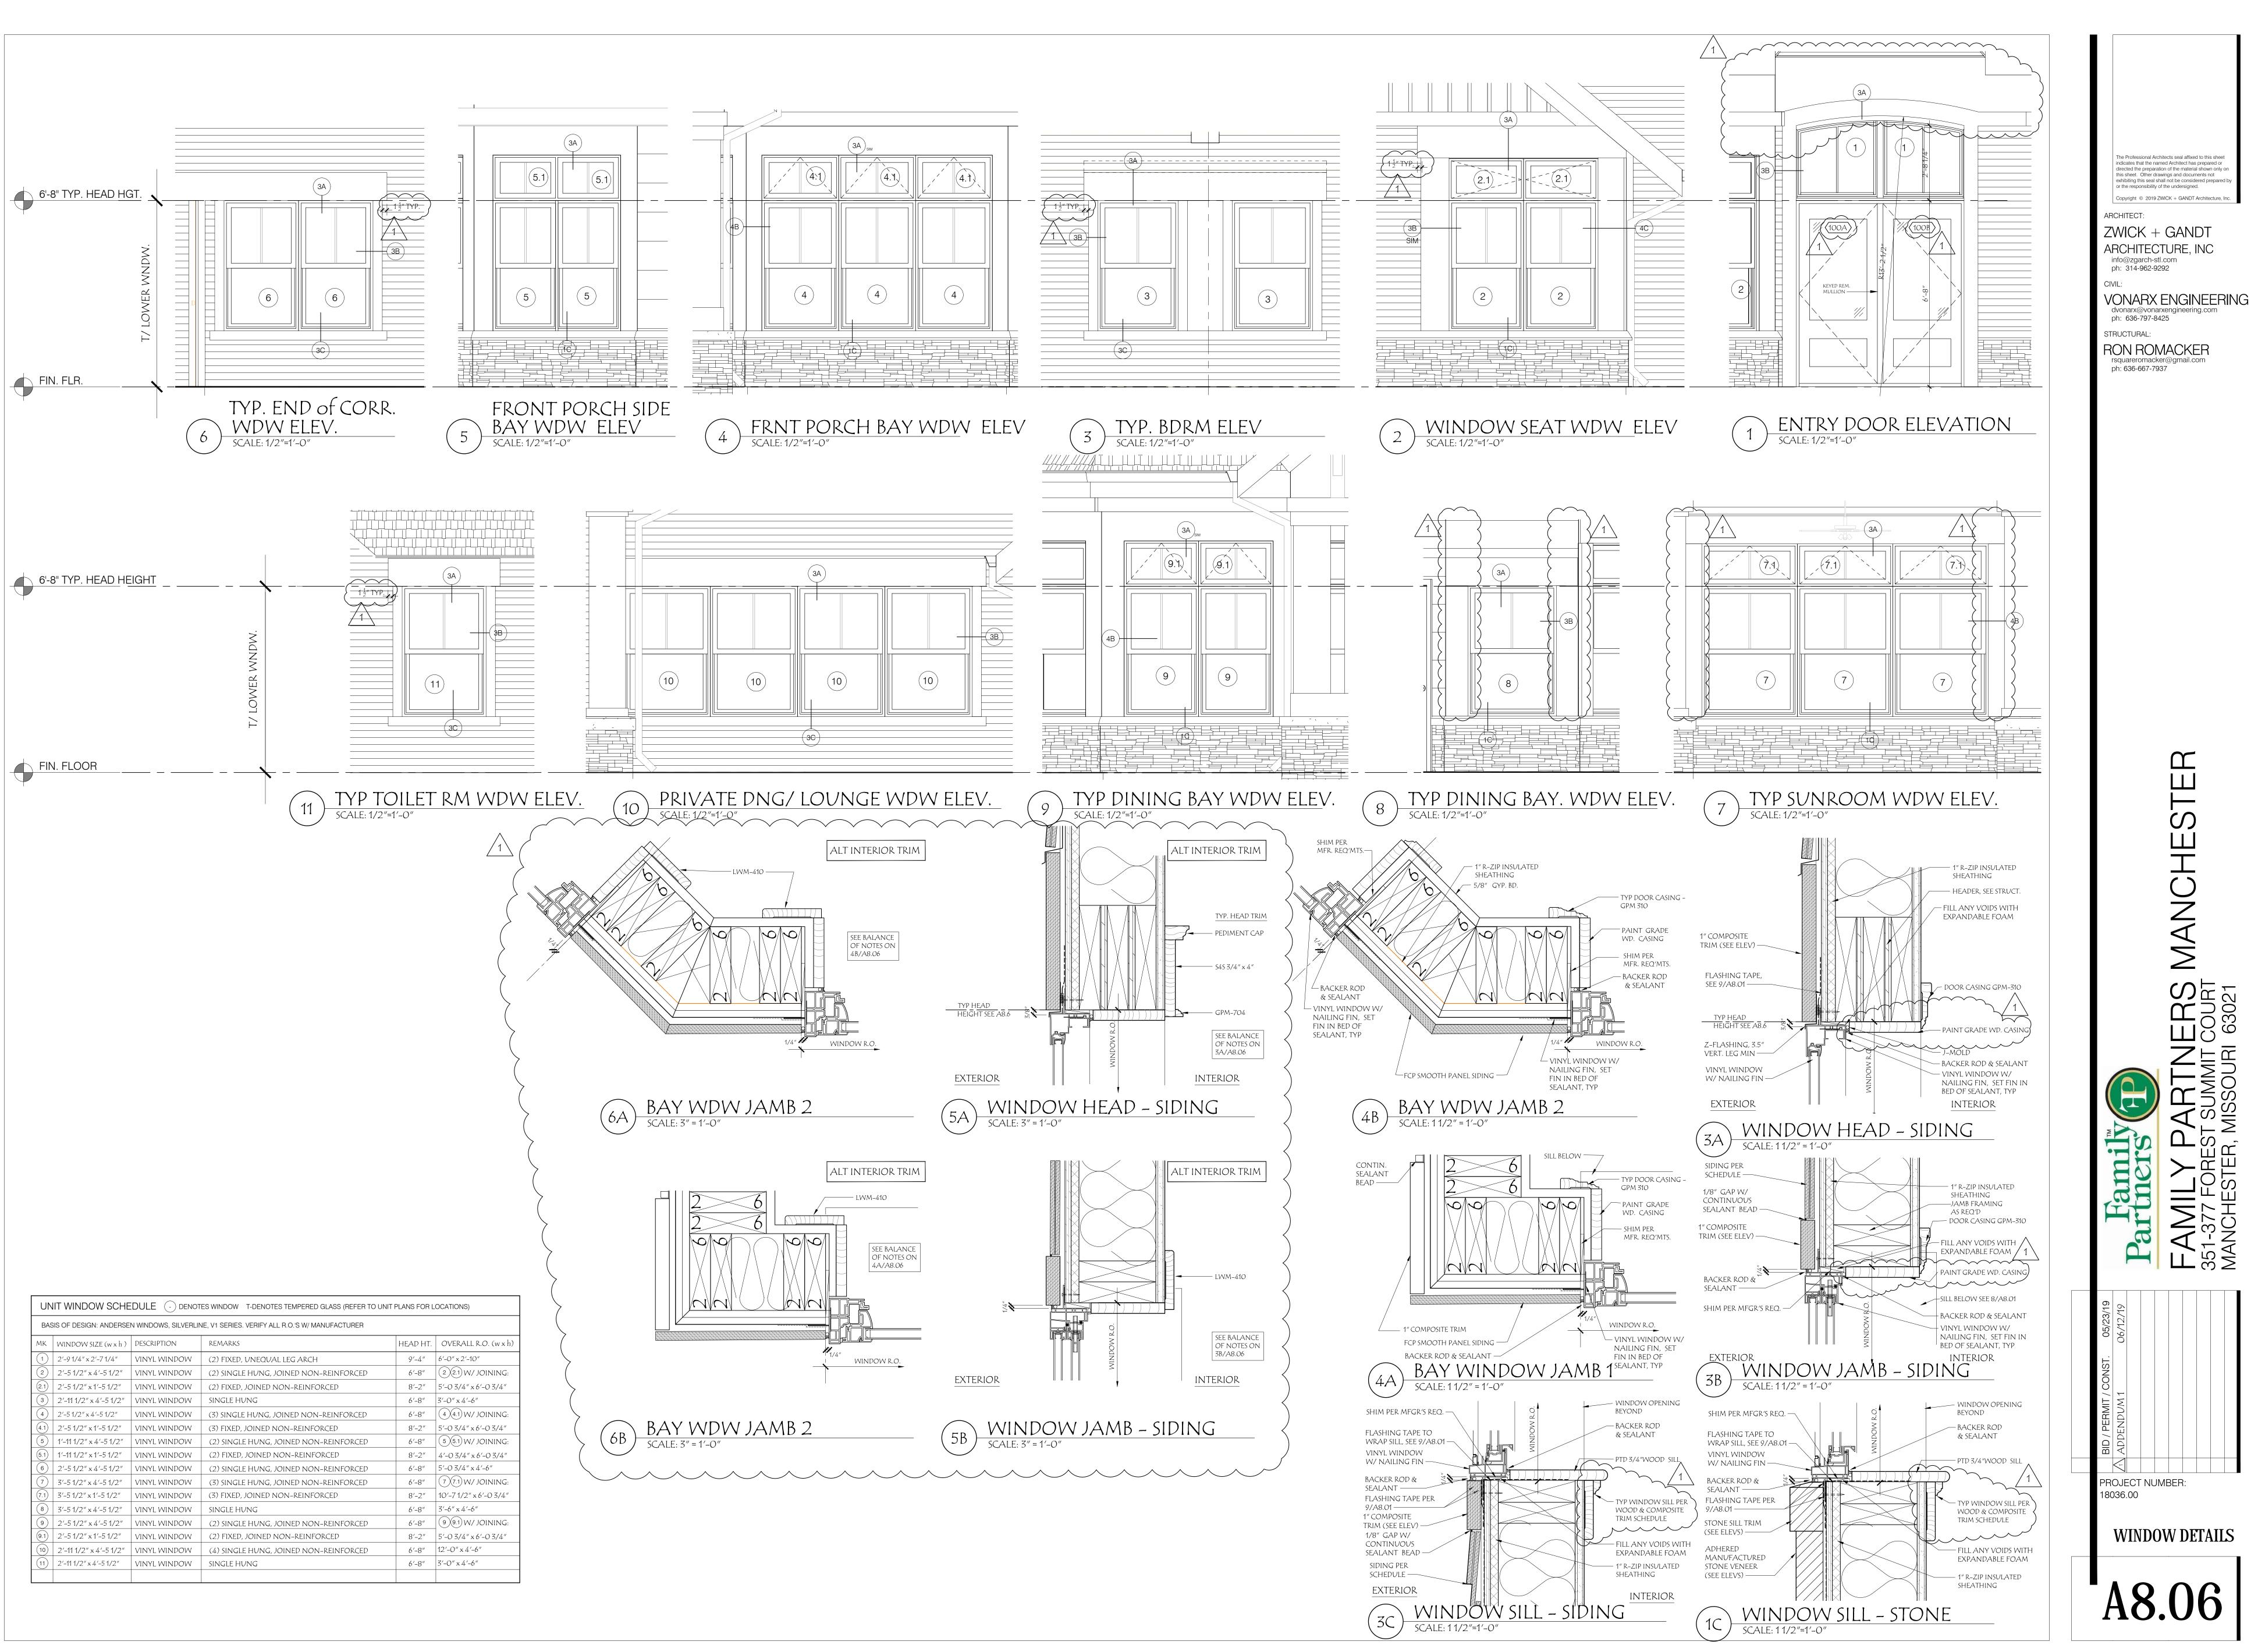

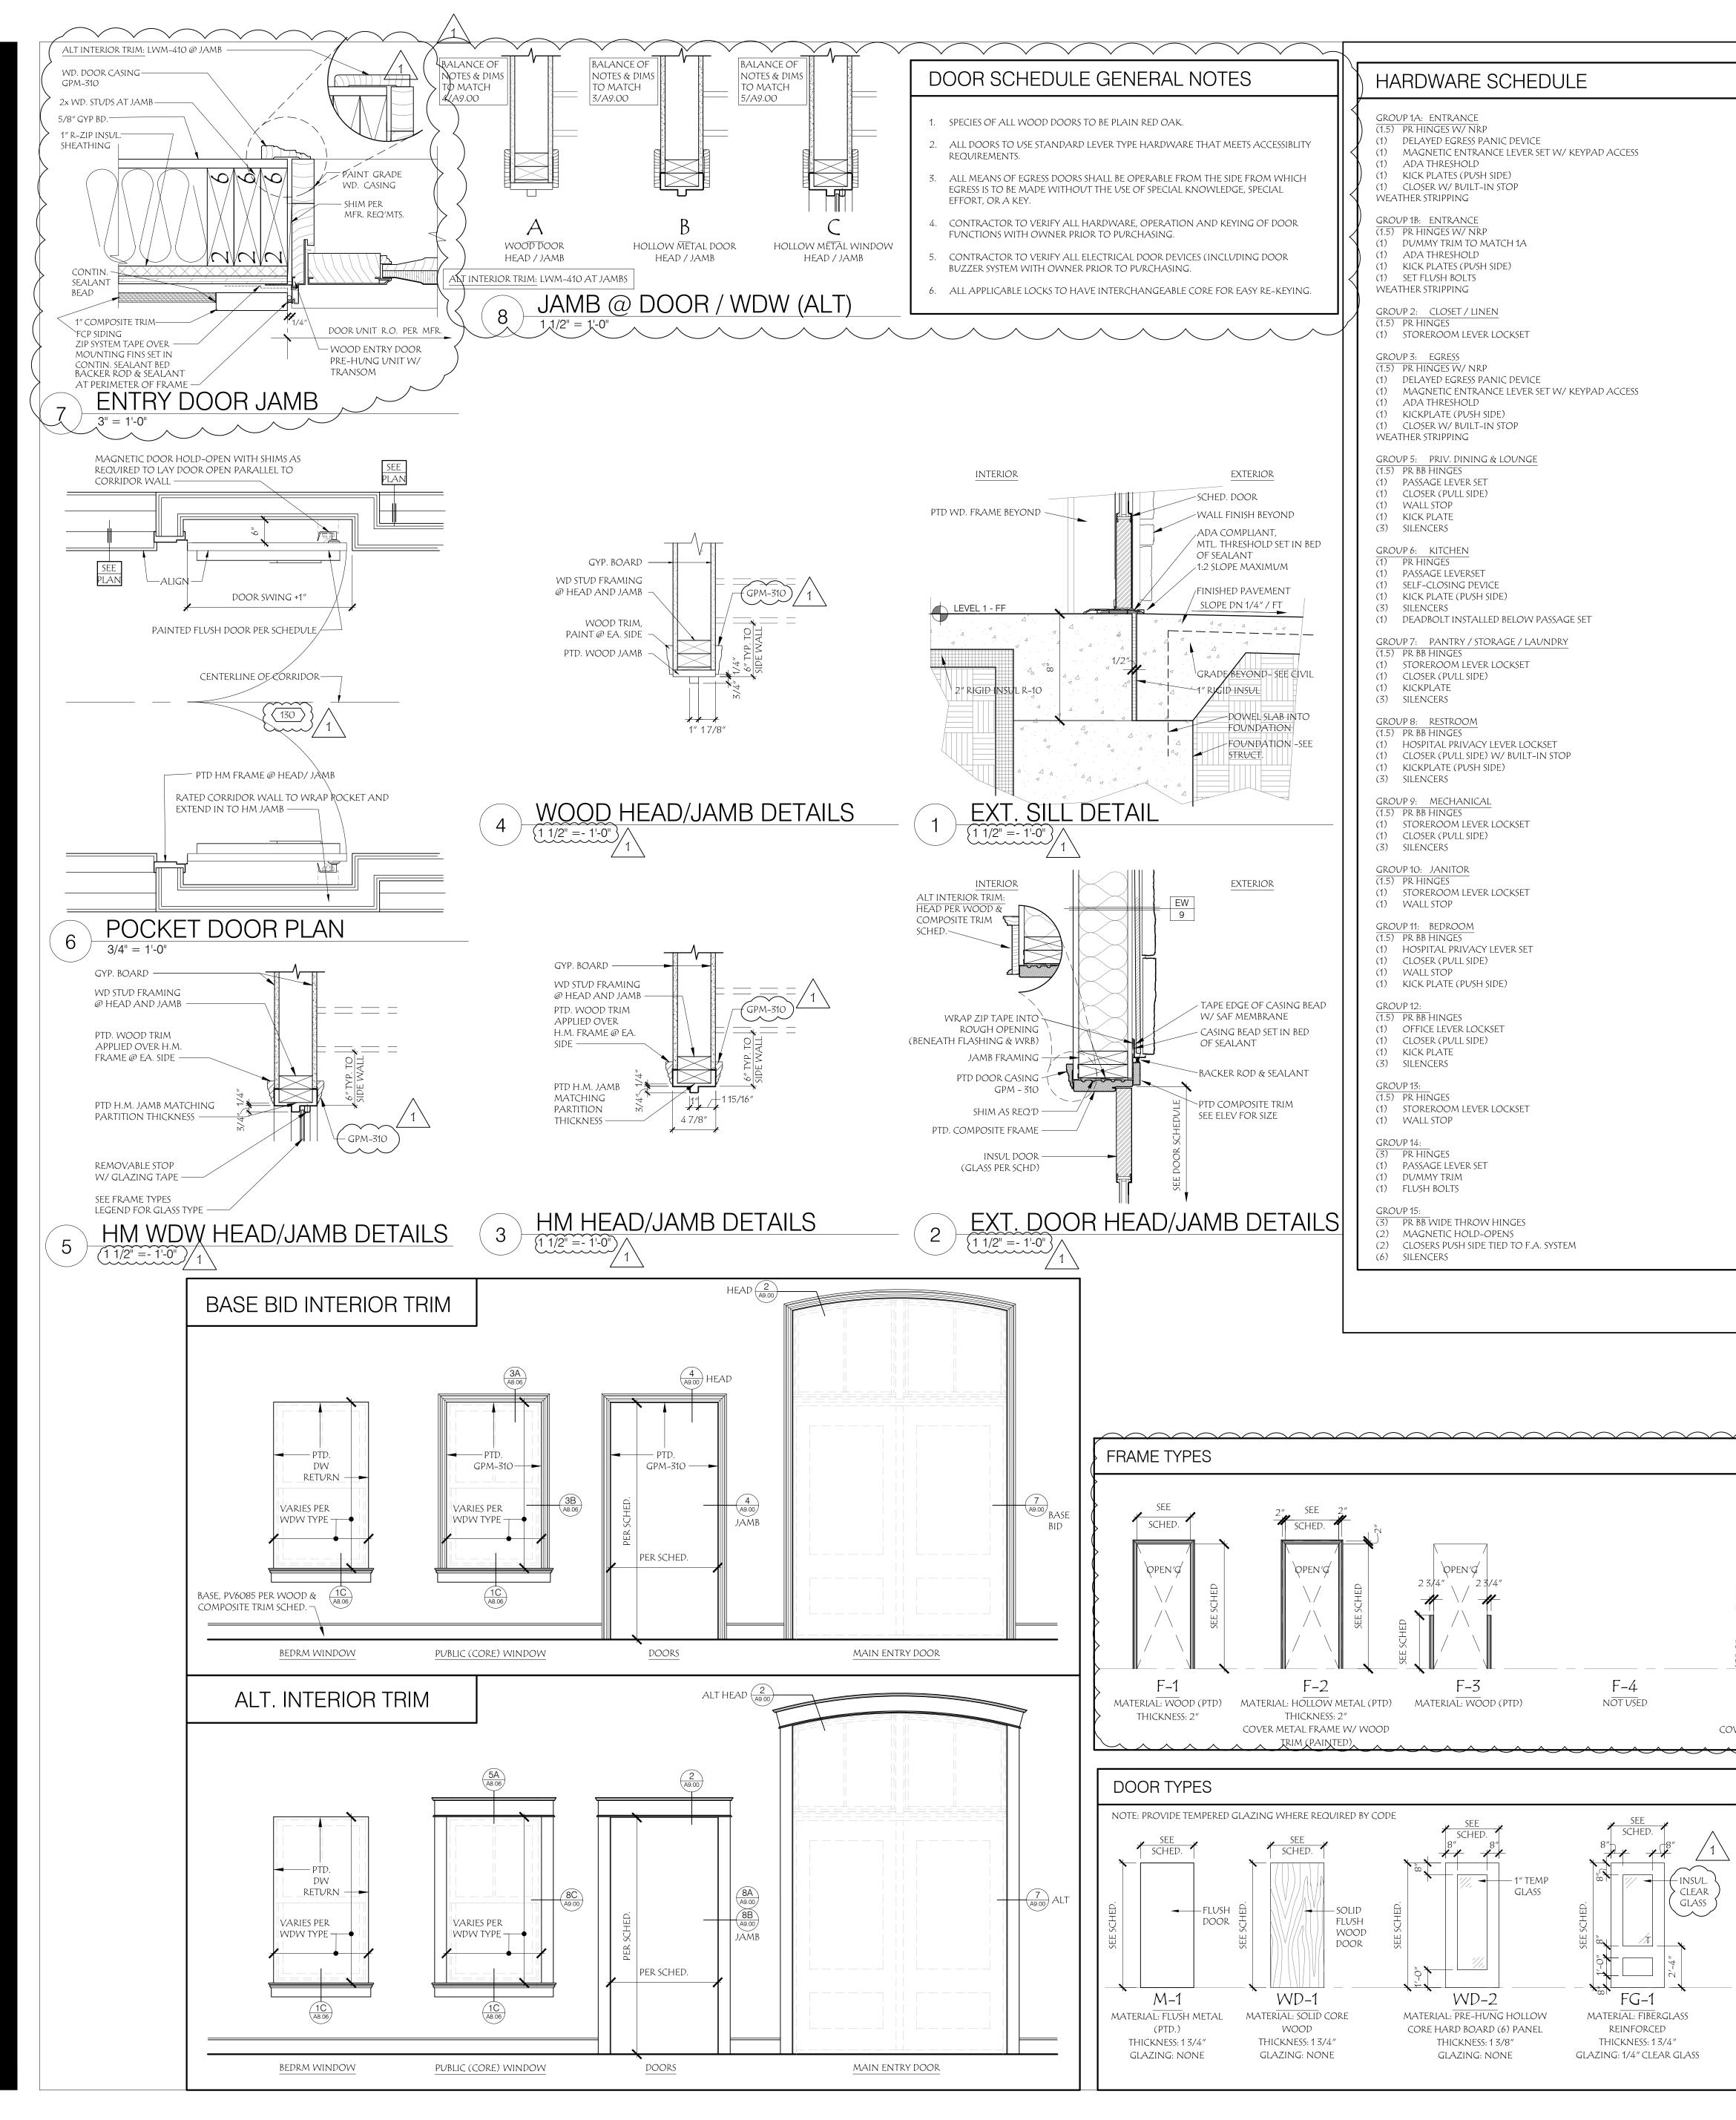

		DOOR	SCHEDU	JLE							
		DOOR NO.	DOOR TYPE	SIZE	FRAME TYPE	HARDWARE	HEAD	DETAILS JAMB	SILL	LABEL	REMARKS
		MAIN FLOOR 100A 100B	FG-1 FG-1	3'-0" X 6'-8" 3'-0" X 6'-8"	1/A8.06	1A 1B	2/A9.00 2/A9.00	2/A9.00 2/A9.00	1/A9.00 1/A9.00	-	3
		1000 100C	D1 FG-1	3'-0" X 6'-8" 3'-0" X 6'-8"	F1 F1	2	4/A9.00 2/A9.00	4/A9.00 2/A9.00	- 1/A9.00	-	
		101B 102A	FG-1 WD-2	3'-0" X 6'-8" 3'-0" X 6'-8"	F1 F2	<sup>3</sup> 5	2/A9.00 3/A9.00	2/A9.00 3/A9.00	1/A9.00	20 MIN.	 1
		102B	WD-2 1 D4	3'-0" X 6'-8" 3'-0" X 3'-6"	F2 F3	5	3/A9.00 4/A9.00	3/A9.00 4/A9.00	-	20 MIN.	1
		106 107A	D1 WD-2	) 3'-0" X 6'-8" 3'-0" X 6'-8"	F2 F2	7	3/A9.00 3/A9.00	3/A9.00 3/A9.00	-	20 MIN. 20 MIN.	1
		107B 108	WD-2 D1	3'-0" X 6'-8" 3'-0" X 6'-8"	F2 F2	5	3/A9.00 3/A9.00	3/A9.00 3/A9.00	-	20 MIN. 20 MIN.	1 1, 7
		108A 108B	WD-1 D1	2'-4" X 6'-8" 2'-4" X 6'-8"	F2 F1	9 2	3/A9.00 4/A9.00	3/A9.00 4/A9.00	-	45 MIN.	1
		109 110	D1 D1	3'-0" X 6'-8" 3'-0" X 6'-8"	F2 F2	7 7	3/A9.00 3/A9.00	3/A9.00 3/A9.00	-	20 MIN. 20 MIN.	1
		110A 111	WD-1 D1	2'-0" X 6'-8" 3'-0" X 6'-8"	F1 F2	10 8	4/A9.00 3/A9.00	4/A9.00 3/A9.00	-	- 20 MIN.	- 1, 7
		111A 111B	WD-1 D1	2'-0" X 6'-8" 2'-0" X 6'-8"	F2 F1	9 2	3/A9.00 4/A9.00	3/A9.00 4/A9.00	-	45 MIN.	1
		112 113	D1 D1	3'-0" X 6'-8" 3'-0" X 6'-8"	F2 F2	7 11	3/A9.00 3/A9.00	3/A9.00 3/A9.00	-	20 MIN. 20 MIN.	1
		114 115	D1 D1	3'-0" X 6'-8" 3'-0" X 6'-8"	F2 F2	11 11	3/A9.00 3/A9.00	3/A9.00 3/A9.00	-	20 MIN. 20 MIN.	1
		116 117	D1 D1	3'-0" X 6'-8" 3'-0" X 6'-8"	F2 F2	11 11	3/A9.00 3/A9.00	3/A9.00 3/A9.00		20 MIN. 20 MIN.	1
		118 119	D1 D1	3'-0" X 6'-8" 3'-0" X 6'-8"	F2 F2	11 11	3/A9.00 3/A9.00	3/A9.00 3/A9.00	-	20 MIN. 20 MIN.	1
		120 121	D1 D1	3'-0" X 6'-8" 3'-0" X 6'-8"	F2 F2	11 11	3/A9.00 3/A9.00	3/A9.00 3/A9.00	-	20 MIN. 20 MIN.	1
		122	D1 D1	3'-O" X 6'-8" 3'-O" X 6'-8"	F2 F2	11	3/A9.00 3/A9.00	3/A9.00 3/A9.00	-	20 MIN. 20 MIN.	1 1
		124	D1 D1 D1	3'-O" X 6'-8" 3'-O" X 6'-8"	F2 F2	11 7	3/A9.00 3/A9.00	3/A9.00 3/A9.00	-	20 MIN. 20 MIN. 20 MIN.	1 1
		125 126 126A	D1 D1 D1	3'-0" X 6'-8" 2'-0" X 6'-8"	F2 F1	8	3/A9.00 4/A9.00	3/A9.00 4/A9.00	-	20 MIN.	1, 7
		126B	WD-1	2′-8″ X 6′-8″	F2	9	3/A9.00 3/A9.00	3/A9.00	-	- 45 MIN.	- 1
		127 127A	WD-1	3'-0" X 6'-8"	F2 F1	12 13	4/A9.00	3/A9.00 4/A9.00	-	20 MIN. -	
		128 128A		3'-0" X 6'-8" 5'-0" X 6'-8"	F2 F1	8 14 7	3/A9.00 4/A9.00	3/A9.00 4/A9.00	-	20 MIN. -	1, 7
		129 129A	WD-1	3'-0" X 6'-8"       3'-0" X 6'-8"	F2 F2	7 9	3/A9.00 3/A9.00	3/A9.00 3/A9.00	-	20 MIN. 45 MIN.	1
		( <u>130</u> 131	WD-1	6'-O" X 6'-8" 3'-O" X 6'-8"	F2 F1	15 3 7	3/A9.00 4/A9.00	3/A9.00 4/A9.00	-	20 MIN. -	5,6
		-	- WD-1	3'-0" X 6'-8" -	F1	-	4/A9.00 -	4/A9.00 -	-	-	5, 6
		-	-	-	-	-	-	-	-	-	-
		-	-	-	-	-	-	-	-	-	
		_	-		_	-	-	-	-	-	
		DOOR	SCHEDL	JLE REMARKS							
			·····	VIDTH MATCHING WALL THI		AINTED TRIM OV	/ER HOLLOW M	TL FRAME, SEE A	8.06 FOR BASE I	BID & ALT TRIM PRO	OFILES. 1
		3 A	SCTIVE LEAF								
		5 (N	OT USED 1	DR WALL COLOR							
		7 U	NDERCUT DOOR			~ /	1				
									$\sim$		
V V Y	v v						¥ ¥	<u> </u>	¥ ¥ ¥		<u> </u>
1		5′-5″			1'-31/2"	1	7'-2"	/		6'	<b>x</b>
2″ ~	2″ 1′-7″	<u>1'-7" (1'-7"</u> 2"	/	1'-31/2" 1'-31/ 2" 2" 2" 4 4 4	2" 2"	2"		2″ -7″ 1′-7″ 2″			1′-9″ 2″
									2,-2 " 2,-2		
5′-8″				5'-8"		5′-8″			,' 2, 7		
× ۲	т	т		т т	т	, " 	т	т	3'-4"		
MATE	ERIAL: HC	F-5 DILOW METAL (F CKNESS: 2"	PTD)	<b>F–6</b> Material: Hollow M Thickness: 2		MAT	F–7 Ferial: Hollov Thickne:	N METAL (PTD)		F-8 MATERIAL: HOLLC THICKNI	W METAL (PTD)
	L FRAME			VER METAL FRAME W/ WOC GLAZING: TEMPE	DD TRIM (PAINTE		AL FRAME W/ V				WOOD TRIM (PAINTE
						7				∧ ∕ wd tri	Ame dashed to all M cover per base bii
	, SEE					-				1 INTR. TI SELECTE	RIM ADDED WHERE
4 3/4"-		4 3/4"	$\langle $	$\sum$							
4 3/4 "	-			Ş							
SEE SCHED.					see Sched.						
SEE -				SEE SCHED.							
	D1		D3		D4	_					
	rial: sol Masoni <sup>-</sup>	ΓE			IAL: SOLID CORE WOOD						
SM	100th fi	N15H	/1		CKNESS: 1 3/4"						



,		GENERAL NOTES		NO.	ROOM NAME	FLOORIN	NG BASE FIN	nish n	NORTH WALL	EAST WALL	ALLS SOVTH WALL	WEST WALL	CE FINISH	ILING HEIGHT	
PROVIDE SOLID VINYL RE		MATERIALS OF DIFFERENT THICKNESS. ALL CARPET/VCT, CARPET/CONC. & XX-K.	$\left \right\rangle$	100A	FOYER COATS	LVT-1 LVT-1	B-1		PT-1 PT-1	PT-1 PT-1	PT-1 PT-1	PT-1 PT-1	PT-2 PT-2		1, 7
		Y LICENSED, EXPERIENCED AND/ OR AND A MINIMUM 3 YEARS EXPERIENCE IN	$\left \right\rangle$	101 102 103	SUNROOM LOUNGE LIVING ROOM	LVT-1/CP CPT-1 LVT-1	B-1		PT-1 PT-1 PT-1	PT-1 PT-1 PT-1	PT-1 PT-1 PT-1	PT-1 PT-1 PT-1	PT-2 PT-2 PT-2		3, 7 3, 7, 10
good standing by the installers must be ful	E MANVFACTURER OF THAT PRC LLY AWARE OF:	DDUCT/ MATERIAL (NO EXCEPTIONS). ALL	$\left \right\rangle$	103 104 105	DINING	LVT-1 LVT-1	B-1		PT-1 PT-1 PT-1	PT-1 PT-1	PT-1 PT-1	PT-1 PT-1	PT-2 PT-2 PT-2		4, 7 9, 10
BEING INSTALLED A 2.2. SUBSTRATE REQUIR	ND THE LATEST PUBLISHED INSTA EMENTS OR USE OF THE THIS MA			106 107	PANTRY PRIVATE DINING/LIVING ROOM	LVT-1	B-1		PT-1 PT-1	PT-1 PT-1	PT-1 PT-1	PT-1 PT-1	PT-2 PT-2		
2.3. NO PRODUCT IS TO I		t does not meet or exceed the latest Ation by the manufacturer.		108 108A	BATHROOM #1 MECH.	PLY-1 CONC		1	PT-1 PT-1	PT-1 PT-1	PT-1 PT-1	PT-1 PT-1	PT-2 PT-2		
	ATION ARE TO BE BROUGHT TO T	ND THE EXISTING CONDITIONS, SUBSTRATES, HE ATTENTION OF THE ARCHITECT PRIOR		108B 109	LINEN STORAGE	PLY-1 LVT-1	B-1	1	PT-1 PT-1	PT-1 PT-1	PT-1 PT-1	PT-1 PT-1	PT-2 PT-2		
		DEVIATIONS, SUB-CONTRACTOR TO	$\left \left\langle \right\rangle \right $	110 110A	LAUNDRY JANITOR	LVT-1 CONC	. В-1		PT-1 PT-1	PT-1 PT-1	PT-1 PT-1	PT-1 PT-1	PT-2 PT-2		
INSPECT SVBSTRATE CON	NOTIONS AND IDENTIFY ANY NE NEW MATERIALS TO ENSURE FLC	EDED CORRECTIONS PRIOR TO	$\left \right\rangle$	111 111A 111B	BATHROOM #2 MECH. LINEN	PLY-1 CONC	. B–1		PT-1 PT-1 PT-1	PT-1 PT-1 PT-1	PT-1 PT-1 PT-1	PT-1 PT-1 PT-1	PT-2 PT-2 PT-2		
		NG FLOOR MATERIALS AND/ OR		112 113	STORAGE BEDROOM 7	1 LVT-1	<u>→</u> B-1		PT-1 PT-1	PT-1 PT-1	PT-1 PT-1 PT-1	PT-1 PT-1	PT-2 PT-2 PT-2		
	O PROVIDE A SMOOTH UNDETEC FERING MATERIAL. INSTALL EDGI	TABLE TRANSITION AND ALIGNING TOP ING OR TRANSITION STRIPS PER		114 115	BEDROOM 8 BEDROOM 9	LVT-1 LVT-1	B-1		PT-1 PT-1	PT-1 PT-1	PT-1 PT-1	PT-1 PT-1	PT-2 PT-2		
5. PROVIDE WOOD BLOCKII	ng or steel framing, plates,	straps, etc. in gypsum board		116 117	BEDROOM 10 BEDROOM 11	LVT-1 LVT-1	B-1		PT-1 PT-1	PT-1 PT-1	PT-1 PT-1	PT-1 PT-1	PT-2 PT-2		
limited to wall cabin	iets, Marker and Tackboard	CES AND EQUIPMENT INCLUDING BUT NOT S, HANDRAILS, WOOD TRIM, SHELVING, BING & FIRE PROTECTION EQUIPMENT AND	$\left \right\rangle$	118 119	BEDROOM 12 BEDROOM 1	LVT-1 LVT-1	B-1		PT-1 PT-1	PT-1 PT-1	PT-1 PT-1	PT-1 PT-1	PT-2 PT-2		
DEVICES AS WELL AS OW	iner furnished items.		$\left \right\langle$	120 121 122	BEDROOM 2 BEDROOM 3 BEDROOM 4	LVT-1 LVT-1 LVT-1	B-1		PT-1 PT-1 PT-1	PT-1 PT-1 PT-1	PT-1 PT-1 PT-1	PT-1 PT-1 PT-1	PT-2 PT-2 PT-2		
5. KUN FLOOK FINISHES UN	NDER ALL APPLIANCES & EQVIPN	IENT.		122 123 124	BEDROOM 5 BEDROOM 6	LVT-1 LVT-1	B-1		PT-1 PT-1 PT-1	PT-1 PT-1 PT-1	PT-1 PT-1 PT-1	PT-1 PT-1 PT-1	PT-2 PT-2 PT-2		
			- ר	125 126	STORAGE BATHROOM #4	LVT-1 PLY-1	B-1	1	PT-1 PT-1	PT-1 PT-1	PT-1 PT-1	PT-1 PT-1	PT-2 PT-2		8(9)
	& COMPOSITE TI			126A 126B	LINEN MECH.	PLY-1 CONC	. B–1	1	PT-1 PT-1	PT-1 PT-1	PT-1 PT-1	PT-1 PT-1	PT-2 PT-2		
WD. PROFILE	GPM #	LOCATION		127 127A	NURSE STATION STORAGE	LVT-1	B-1	1	PT-1 PT-1	PT-1 PT-1	PT-1 PT-1	PT-1 PT-1	PT-2 PT-2		
	GPM-121	CROWN MOLD #1	$ \langle \rangle$	128 128A 129	BATHROOM #3 LINEN LAVNDRY	PLY-1 PLY-1 LVT-1	PLY-		PT-1 PT-1 PT-1	PT-1 PT-1 PT-1	PT-1 PT-1 PT-1	PT-1 PT-1 PT-1	PT-2 PT-2 PT-2		
Ň	PT GRADE WOOD -INT.,	INTR. PTD. TO MATCH		129A	MECH	CONC	. B–1		PT-1 PT-1 PT-1	PT-1 PT-1	PT-1 PT-1	PT-1 PT-1	PT-2 PT-2 PT-2		2, 5, 7
31 <sup>4</sup> + 31	COMPOSITE-	EXTR. PTD TO MATCH		131	)HALL HALL	LVT-1 LVT-1			PT-1 PT-1	PT-1 PT-1	PT-1 PT-1	PT-1 PT-1	PT-2 PT-2		2, 5, 7 1 2, 5, 7 1
	EXT.	WHITE TRIM		133	HALL -	LVT-1 -	B-1		PT-1	PT-1 -	PT-1 -	PT-1 -	PT-2 -		2, 5, 7
				-	-	-	-		-	-	-	-	-		
	GPM-58	CROWN MOLD #2	$\left \left\langle \cdot\right\rangle \right $		~				-	-	-	-	-		
	PT GRADE WOOD -INT.,	INTR. PTD. TO MATCH		DENOTATION	MANUFACTURER		STYL	E			LS FINISH		SIZE	CO	NTACT REMARKS
51	COMPOSITE-	INTR. PTD TO MATCH		B-1	ROPPE INPRO CORPORATION	TRADITIONAL CO (FLEXIBLE CORNER	ve base #pv60 guards	35	~~~~~~~~~~~~~~~~~~~~~~~~~~~~~~~~~~~~~~~	WHITE	~~~~~	5 1/2" 2" WINGS	,	~~~~~~~~~~~~~~~~~~~~~~~~~~~~~~~~~~~~~~~	SEE A5.00 4' TALL, FINISH TO CLOSELY MATCH WALL COVERI
	EXT.	WHITE TRIM		CONC CPT-1	FORBO ELOORING SYSTEM										SEALED CONCRETE
	PV6085	TYP. VINYL		PLY-1	DESCO MOHAWK	GRANITE SERIES BARNWOOD	$\sim$	~~~~				7.24″ x 38			4" COVE BASE & FLOOR SEE 8/A4.00
1/2 "		WALL BASE PV6085 #85 FASHION	$\left \right\rangle$	PLAM-1	WILSONART	TO BE SELECTED	FGG SHFLI			TO BE SELECTE	ED	7.24 × 56			COUNTER & CABS BACK OF HOUSE
Ω		ROPPE CONTOURS	$\left \left\langle \right\rangle \right $	PT-2	SHERWIN WILLIAMS	INTERIOR LATEX -	- FLAT			-					- WOOD TRIM PAINT
		WHITE		55-2	silestone silestone	ANTI-MICROBILE						13MM			WALL PANELS AT SHOWERS KITCHEN COUNTERS
	$\bigcirc$ DCAS5	TYP. CHAIR RAIL		SV-1 VP-1	TEKNOFLOR/SHANNON	MOUNTAINSCAPE PALLADIUM RIGID	SHEET			TBD		0.040″ TÌ	HICK		FINISH TO RESEMBLE WALL COVERING
1/2"		GARDEN STATE LUMBER, DESIGNER		1				R		IISH SCHI	EDULE RE	MARKS			
		COLLECTION, PRIMED								DLVMNS WALL CO					
		POPLAR						2		ACROVYN WAINS 5et – see floor p	SCOT & TRIM UP TO PLAN	CHAIR RAIL HEIGH	T.		
2 3/4"	GPM-310	WINDOW & DOOR CASING W/ PT. GR.	$\left \left\langle \right\rangle \right $						4 PROVIDE	ACROVYN WALL .IL 1/A9.03 FOR (A	PROTECTION & TRI	m from undersid	PE OF COVNTE	RTOP TO TOP O	DF BASE.
3/4" × 2 3/4"		WOOD						6	6 PROVIDE	4 FOOT HIGH WH	HITE PEBBLE FINISH		UTH AND WE	ST WALLS W/ TC	DP TRIM ABOVE MOP SINK
<b>Α</b>		TYP. HEAD TRIM	$\left  \right\rangle$					5	8 POLYMER	R FLOOR & 4″ HIG		BASE W/ 13MM SOLI	D SVRFACE W	'ALL PANELS AT	SHOWER. SEE 8/A4.00
	A: PEDIMENT CAP	ALONG DOOR								SHED WOOD CAB	E SOLID SVRFACE CC	DUNTERS			
D	B: S4S 3/4" x 5	CASINGS & WINDOW	$\left  \right\rangle$				1		11 NOT USEI	D CAL POLYMER BA	SE 9 / A4.00				
	1/2" C: GPM-704	HEADS ALT. INTERIOR	$ \langle$				<u> </u>								
	0. OF IVI-704	TRIM PACKAGE	$\left \right\langle$												
C	1		+)												
		TYP. WINDOW SILL													
	○D: WM1021,	ALONG WINDOW													
	11/16" x 4 3/4"	ALONG WINDOW SILLS													
		ALONG WINDOW SILLS WM1021 FLAT STOOL GARDEN STATE	.,												
	11/16" x 4 3/4" E: GPM-748	ALONG WINDOW SILLS WM1021 FLAT STOOL GARDEN STATE LUMBER, PRIMED													
7" 2 1/4" 4 3/4" F F	11/16" x 4 3/4" E: GPM-748 ◇ F: LWM-410	ALONG WINDOW SILLS WM1021 FLAT STOOL GARDEN STATE LUMBER, PRIMED PINE													
7" 7" 2 1/4" 4 3/4" F F TRIN	11/16" x 4 3/4" E: GPM-748 ◇ F: LWM-410	ALONG WINDOW SILLS WM1021 FLAT STOOL GARDEN STATE LUMBER, PRIMED PINE													
TRIN GRAVOIS PLAN ST. LO	11/16" x 4 3/4"         E: GPM-748         F: LWM-410         ✓ F: LWM-410         INING MILL COMF         JUIS, MO. 63118.	ALONG WINDOW SILLS WM1021 FLAT STOOL GARDEN STATE LUMBER, PRIMED PINE RENCED BY: PANY, 3026 JUNIATA ST 314-776-2800													
TRIN GRAVOIS PLAN ST. LO	11/16" x 4 3/4" E: GPM-748 F: LWM-410	ALONG WINDOW SILLS WM1021 FLAT STOOL GARDEN STATE LUMBER, PRIMED PINE RENCED BY: PANY, 3026 JUNIATA ST 314-776-2800													
TRIN GRAVOIS PLAN ST. LO http:	11/16" x 4 3/4" E: GPM-748 F: LWM-410	ALONG WINDOW SILLS WM1021 FLAT STOOL GARDEN STATE LUMBER, PRIMED PINE RENCED BY: PANY, 3026 JUNIATA ST 314-776-2800													
TRIN GRAVOIS PLAN ST. LO http: GARDEN OAKL	11/16" x 4 3/4" E: GPM-748 F: LWM-410 INING MILL COMF OUIS, MO. 63118. //www.gravoisplar N STATE LUMBER AND, NJ. 07436.	ALONG WINDOW SILLS WM1021 FLAT STOOL GARDEN STATE LUMBER, PRIMED PINE RENCED BY: PANY, 3026 JUNIATA ST 314-776-2800 hingmill.com/												_	
TRIN GRAVOIS PLAN ST. LO http: OAKL	11/16" x 4 3/4" E: GPM-748 F: LWM-410 INING MILL COMF OUIS, MO. 63118. //www.gravoisplar	ALONG WINDOW SILLS WM1021 FLAT STOOL GARDEN STATE LUMBER, PRIMED PINE RENCED BY: PANY, 3026 JUNIATA ST 314-776-2800 hingmill.com/											V SI	INYL CHAIR RAI	1 IL, DCAS5, MPOSITE
$= \frac{F}{2 + 4 + 4 + 4 + 4 + 4 + 4 + 4 + 4 + 4 + $	11/16" x 4 3/4" E: GPM-748 F: LWM-410 INING MILL COMF OUIS, MO. 63118. //www.gravoisplar N STATE LUMBER AND, NJ. 07436.	ALONG WINDOW SILLS WM1021 FLAT STOOL GARDEN STATE LUMBER, PRIMED PINE RENCED BY: PANY, 3026 JUNIATA ST 314-776-2800 hingmill.com/											V SI	INYL CHAIR RAI	1 IL, DCAS5, MPOSITE

	1	PAINT COLUMNS WALL COLOR.									
	2	INSTALL ACROVYN WAINSCOT & TRIM VP TO CHAIR RAIL HEIGHT.									
	3	CPT-1 INSET - SEE FLOOR PLAN									
	4	PROVIDE ACROVYN WALL PROTECTION & TRIM FROM UNDERSIDE OF COUNTERTOP TO TOP OF BASE.									
	5	SEE DETAIL 1/A9.03 FOR ALL WALLS.									
	6	PROVIDE 4 FOOT HIGH WHITE PEBBLE FINISH FRP PANELS ON SOUTH AND WEST WALLS W/ TOP TRIM ABOVE MOP SINK									
	7	PROVIDE CG (CORNER GUARDS) WHERE INDICATED									
	8	POLYMER FLOOR & 4" HIGH INTEGRAL COVE BASE W/ 13MM SOLID SVRFACE WALL PANELS AT SHOWER. SEE 8/A4.00									
	9	PROVIDE ANTI-MICROBILE SOLID SURFACE COUNTERS									
	10	PRE-FINISHED WOOD CABINETS									
$ \land ]$	11	NOT USED									
1 \(	12	SEE TYPICAL POLYMER BASE 9/ A4.00									
	$\sim$										

